

Report, Survey and Plat of Road from Cinkton Road

Rd #36

To

Mountain Road near Nichols & Frazier's.

Rd #36

State of Oregon

The undersigned reputable householders of said County not interested in the cause through which the road described in the annexed notice is to be laid, nor of kin to any owner thereof, and having appeared at the time and place specified in said notice and having been duly sworn well and truly to examine and certify in regard to the necessity and propriety of the highway applied for; and having proceeded to and personally examined the route of such highway, and heard all reasons that were offered for and against laying out the same, do hereby certify that we are of opinion that the highway applied for and described in the annexed notice plat and survey, is of public utility and would recommend its establishment as a road.

apt 23rd 1874

J. V. Dugger
J. Beauchamp
George Dehaven

Field Notes

County road commencing on Cinkton road near crossing of Walla Walla river and running to mountain road near Nichols & Frazier's.


Station	Bearings	Chains	Miles	Remarks	Station	Bearings	Chains	Miles	Remarks
1	N 61° W	16		Commence on Cinkton Road	10	N 50° W	23		
2	S 75° W	9		To Moss house	11	N 30° W	20		Fripetto's claim
3	S 52° W	4			12	N 33° W	14		
4	S 70° W	11		Ross claim	13	N 8° W	1	2	
5	S 61° W	27			14	N 8° W	25		Spence's claim
6	N 72° W	6			15	N 10° W	9		Dr. Buff
7	N 60° W	7	1		16	N 53° W	6		Dr. Frazier's & Nichols' line
8	N 20° W	2			17	West	82	2 1/2 miles	Between Nichols & Frazier's. In intersection of Mountain road.
9	N 0° W	20		Doc Whitley's					

I certify that above is a correct copy of the field notes of the road surveyed by me as ordered by the court April term commencing at Cinkton road on Walla Walla River and thence down to intersection of road running to Blue Mountains.

J. N. Sharon
Co. Surveyor

10 # 36

Plan of Road from Linkton Road
to
Mountain Road

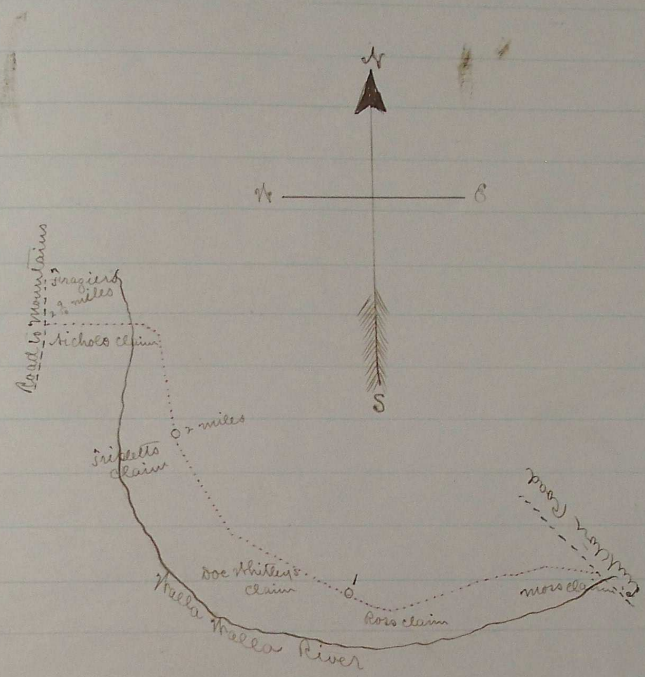

I certify the above is a correct plat of the
road as surveyed by me from the Linkton
road down Malla Malla River thence west
between Nichols & Frazier to intersection of
road running to Blue Mountains

J. N. Sharon
Co. Surveyor

Road granted and located July 9th 1874
See Co. Court Journal "B" page 436