

ROAD No  
302.

Road No 302

Report of Viewers. Field Notes and Plat of Survey of a County Road  
beg. at State Line and ending at the corporate limits of the City of Milton  
Oregon.

Report of Viewers

To the Honorable County Court of Umatilla County and State  
of Oregon.

We the undersigned viewers appointed to view, survey, and  
report upon proposed Road No 302 beg leave to report to your Hon-  
orable body that we met at Milton Nov 16<sup>th</sup> 1887 and were quali-  
fied, and taking to our assistance A. W. Kirk and D. J. Kirk as chain  
bearers and M. F. Smith as marker proceeded to the discharge of  
our duty and having completed the same Nov 18<sup>th</sup> 1887 to the best of  
our ability, we most earnestly recommend that said proposed  
road be established as a County Road as surveyed for the fol-  
lowing reasons viz:

1<sup>st</sup> The location for the road is good.

2<sup>nd</sup> The road is greatly needed, there being parties residing ad-  
jacent to it who have no public roads to travel to and from their  
homes.

3<sup>d</sup> The road would be of great public benefit.

M. F. Smith not appearing on the 18<sup>th</sup> as marker  
H. L. Briggs was qualified and performed the duty on that day.

Respectfully submitted  
this Dec 8<sup>th</sup> 1887

Wm G. Bade  
H B Lee  
Wm Stein } Viewers

Field Notes of the survey  
of Road No 302 for Umatilla Co. Oregon.  
Nov 16<sup>th</sup> 1887.

I set post of legal dimensions, marked R on the south side  
and raised mounds of earth 4x4 feet at base and 18 in. high around  
same, 45 links west of a point 5 chs. and 50 links west of the inter-  
section of the N. bndy. of the State of Oregon with the line bet. Secs  
14 & 15 in Tp 6 N. R 35 E. W. M. The weather being cloudy, and my  
instrument a Solar Compass, I find, by noting lines of fencing  
upon section and state boundary, var. to be practically, N. 20° 30' E.

- 50° 40' E chs run from station at commencing Brook 10 lks wide, run N. W. - 5'
- 15.05 Old irrigating ditch 5 lks. wide, run N. W.
- 17.50 Set angle stake 39 lks. west of pt. and  
Turn 17° 40' Left. To intersect line bet Secs 14 & 15
- 518° 25' E 26.67 Old ditch 6 links wide runs west
- 34.15 Cut A on N. post of base, 51 lks. west of pt. and  
Turn 19° 00 Right, along line bet Secs. 14 & 15

g to be a  
ownship  
te Meri-  
15<sup>th</sup> 1887  
28  
Umatilla  
Oregon,

- S 0° 35' W. 45.10 Spring branch 12 links wide runs N. W.  
 53.60 Ascend steep bluff + 50'  
 54.21 S. W. cor. Sec 14, on steep N. hill side,  
 56.75 Summit; road graded down toward N.  
 69.50 Descend, road in lane on line bet. Secs. 22 & 23  
 74.25 Foot of descent - 30'  
 80.00 Set 1 mile post about 30 links west of point  
 I continue on line between Secs 22 & 23,  
 11.00 M. F. Smith's house, on E. side of lane  
 11.18 Fine Spring on line.  
 20.00 Jas D. Perry's house on W. side of lane.  
 27.00 Enter brush<sup>and</sup> scattering timber along W. W. River  
 28.00 Set angle stake 32 links east of pt. <sup>and</sup>  
 Turn thence 24° 30' Right.
- S 25° 05' W 28.40 Blough 22 links wide runs N. W.  
 31.18 Cut A on round fence post 6 lks. west of pt. <sup>and</sup>  
 Turn 29° 30' Left
- S 4° 25' E 35.71 Set angle stake against fence 13 lks. west. <sup>and</sup>  
 Turn 6° 25' Left
- S 10° 30' E 39.00 Set angle stake 30 links east, against N. Ford's fence  
 on reputed Sec. line bet. Secs. 22 & 23. This point  
 is 3 links east of a Cottonwood tree 2 ft. dia. <sup>and</sup>  
 notched with three notches on opposite sides  
<sup>and</sup> in direction of the road.  
 Turn thence 11° 30' Right
- S 0° 40' W 40.28 Walla Walla River 32 links wide runs N. W.  
 Enter lane N & S on land of A. Moran, deceased  
 51.32 Along lane <sup>and</sup> 20 ft west of N. Ford's fence on reputed  
 line bet. Secs 22 & 23. Set angle stake 30 links E against  
 N. Ford's fence, <sup>and</sup>  
 Turn thence 42° 00' Right
- S 42° 40' W 52.90 Set angle stake in bunch of Elders on W. bank of river  
 30 lks E. Turn thence 46° 30' Left
- S 3° 50' E 56.73 Set angle stake 30 lks east of pt. on N. side of fence runs S & W.  
 Turned thence 2° 30' Right
- S 1° 20' E 66.47 Set angle stake 30 links east of point, <sup>and</sup>  
 Turn 9° 45' Left
- S 11° 05' E 67.45 W. W. River 30 links wide, runs N. E.  
 68.54 Int. reputed line bet. Secs 26 & 27; Set angle stake  
 at fence cor. 6 links E. <sup>and</sup>  
 Turn on line bet Secs 26 & 27 (This point is 638 links North  
 of witness cor. which is a dead willow 6 in. dia, marked  
 on N. W. blaze AM CC <sup>and</sup> on S. W. blaze W B CC

U.  
423  
at  
423,  
W. W. River  
h and  
h and  
ords fence  
Point  
dia. and  
T sides  
N. W.  
eased  
reputed  
to E. against  
nt of river  
ee runs E & W.  
lake  
links North  
dia. marked  
e

70.10 W. W. River 20 links wide runs West.  
 72.50 Set angle stake about 5 links west of fence N & S, and  
 Turn 25° 10' Right around bend in river  
 S 25° 10' W 74.66 Set angle stake 30 links E. of pt. on W. bank of river  
 Turn thence 41° 35' Left, to intersect Sec. line  
 S 16° 30' E 78.62 Int. line bet. Secs 26 & 27, 33 1/3 links South of trees & tree as above  
 Turn thence along said Sec line.  
 South 80.00 Set 2 mile post 30 links west of point in Mr  
 Wellers field.  
 Continue on reputed Sec line, road in lane.  
 " 15.17 Stone Cor. 1/4 S. bet. Secs 26 & 27.  
 18.04 Branch 13 links wide runs N. W.; Mr W<sup>m</sup> Broome on  
 E. side of lane  
 26.75 E. B. Briggs on west side of lane.  
 33.10 Branch 30 links wide runs N. W.  
 39.70 " 10 " " " "  
 40.20 C. Rodgers on west of lane  
 49.50 F. Dullwans, " East " "  
 55.41 Irrigating ditch runs across road west.  
 55.54 Cor. for Secs. 26, 27, 34 & 35  
 57.20 Irrigating ditch runs N. W.  
 63.17 " " 3 lks. wide runs N. W.  
 74.72 " " 4 " " " "  
 W<sup>m</sup> Forsythes on W. of lane.  
 80.00 Set 3 mile post against fence 30 links W. of pt  
 Continue on line bet. Secs. 34 & 35  
 14.25 Geo. Lydell's east of lane  
 14.41 Branch 6 links wide runs N. W.  
 47.30 " 30 " " " west  
 54.71 Cor. for Secs 2, 3, 34 & 35, on Sp line. Leave lane  
 66.35 Branch 10 links wide runs west  
 69.94 " 5 " " " N. W.  
 71.23 " 4 " " " "  
 73.30 " 4 " " " "  
 77.10 " 3 " " " west.  
 77.16 Set angle stake at point, 50 ft N. of R. R. track  
 Turn thence along line, parallel to R. R. track,  
 and 50 ft from center of same.  
 S 67° 15' E 80.00 Set 4 mile post 45 links N. of point.  
 41.00 Intersect line N & S, Center Sec 2, 35 N. R 35 E.  
 The western bndy. of North Millon; Set post  
 for terminus 45 links N. of point in field.



Geo E Arnold  
County Surveyor

Plat of Road No 302.

I hereby certify the following to be a correct plat of the survey of road 302, Townships 5 & 6 N. Range 3 S. East of Willamette Meridian, as made by me, Nov 16, 17 & 18 1887.

Jno C. Arnold  
Surveyor of Umatilla County, Oregon

5x67 35 E

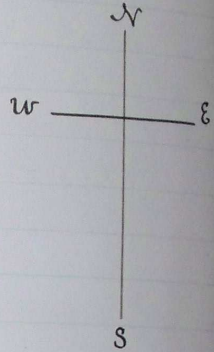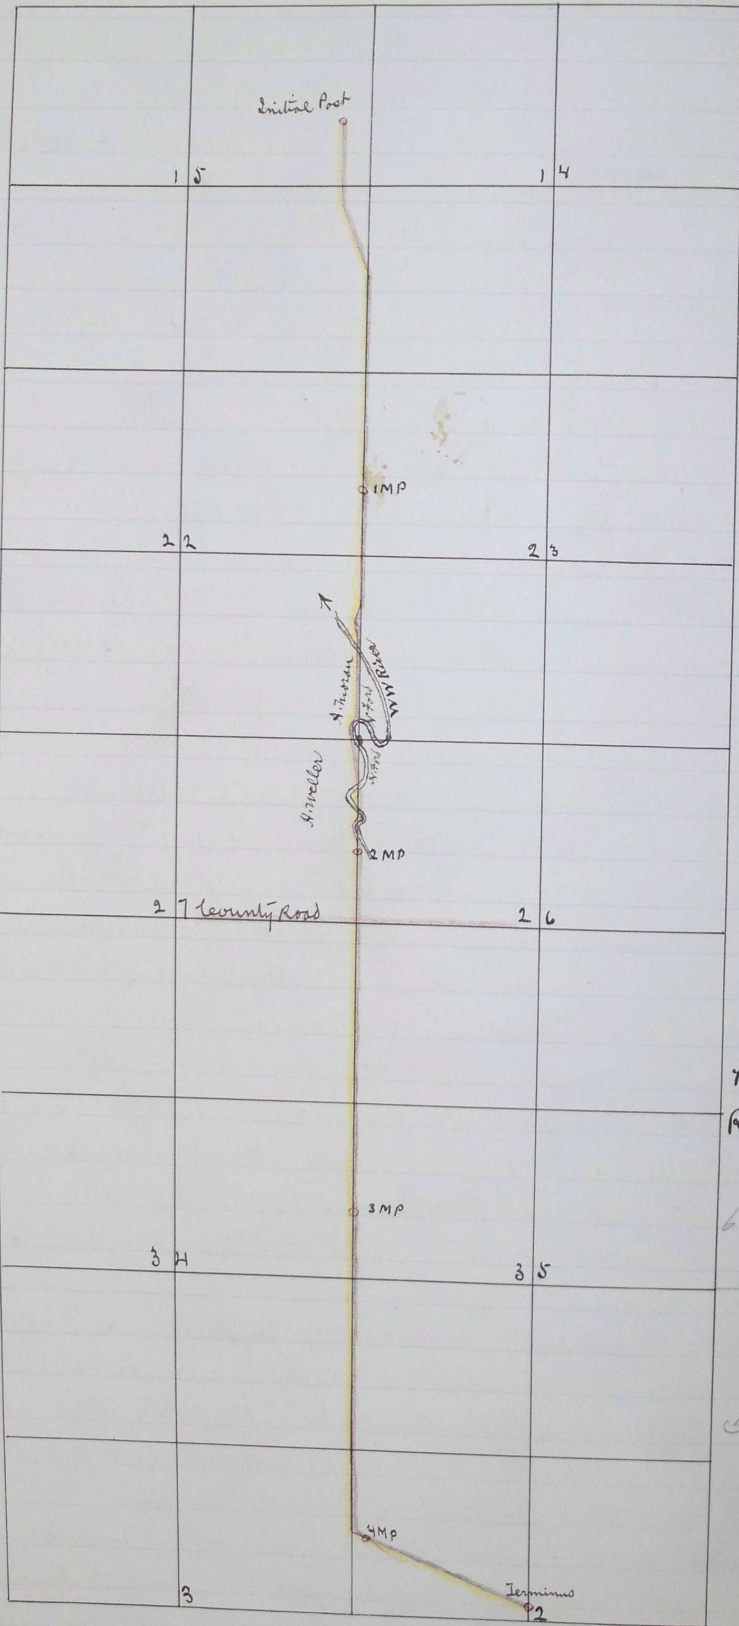

Book 9. page 621  
 " 9. " 706  
 " H " 14  
 Road Granted April 12/88  
 Recorded April 18 1888  
 G. A. Hartman  
 Clerk  
 By J. H. Parkes, Deputy

57

ROAD NO  
306.

No. 3