

Report Survey and Plat of Road, from 80 r. S. of center Sec. 10 T. 4 N. R. 35 E.

Ed #43

To

Millton.

Ed #43

Field Notes of Survey of County Road:

Commencing eighty rods South of center section 10 Township

4 N Range 35 East. to millton:

Set a post 80 rods South of center of Section 10 for initial point
thence North

- 80.00 Set a post for 1 mile
 40.09 Intersect 1° Standard Parallel thence
 East
 9.41 Point of angle thence
 North
 25.50 Set a post for 2 miles thence on same course
 80.20 Set a post for 3 miles
 23.50 Point of angle thence
 N 33° East
 50.50 Set a post for 4 miles Same course
 21.00 Point of angle thence
 N 21° E
 27.00 Enter Dry Creek bottom
 13.50 Point of angle leave Dry Creek bottom thence
 North
 18.00 Point of angle thence
 N 78° E
 3.50 Set a post for 5 miles
 8.00 Point of angle thence
 N 40° E
 23.00 Point of angle thence
 N 60° E
 49.00 6 mile post
 21.00 Point of angle thence (Cole Road)
 N 13° E
 59.00 7 mile post thence
 N $24^{\circ} 30' 74$
 24.00 To terminus in Town of millton
 Surveyed Sept 25, 1875

J. S. Moorhouse

County Surveyor



The undersigned met at Weston on the 25 day
 of Sept and in company with the Surveyor and other suitable
 persons after being qualified proceeded to view survey and
 mark out the road as per order and find that the same is prac-
 ticable We also viewed the road commencing 80 rods South
 of center of Section 10 T. 4 N. R. 35 E. to forks of road near Edwings
 on Dry Creek and believe the same may vacated without
 injury to the traveling public or any private individual for
 the length of said road & bearings we would refer you to County Sur-
 veyor's report. the claim for two days service each. John Miller

(See page 95)

H. J. Hale

ct # 43

Plat of County Road
from
1/4 miles North of Weston to Milton

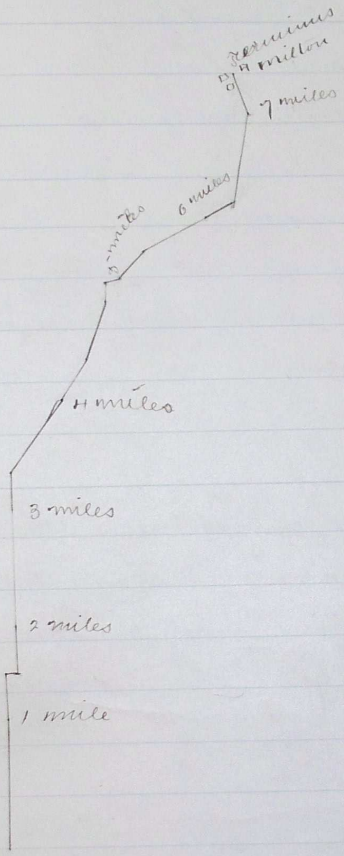

$$\begin{array}{r} 5650 \\ 21 \\ \hline 7750 \end{array}$$

Surveyed Sept. 25 1875
 J. C. Moorhouse
 County Surveyor

Road granted and located Oct. 5th 1875
 See Co. Court Journal "B" page 575