UMATILLA COUNTY OREGON

COUNTY-ENGINEERS-OFFICE

ATHENA-WILDHORSE-MARKET-ROAD

No. 31

CONSTRUCTED LINE
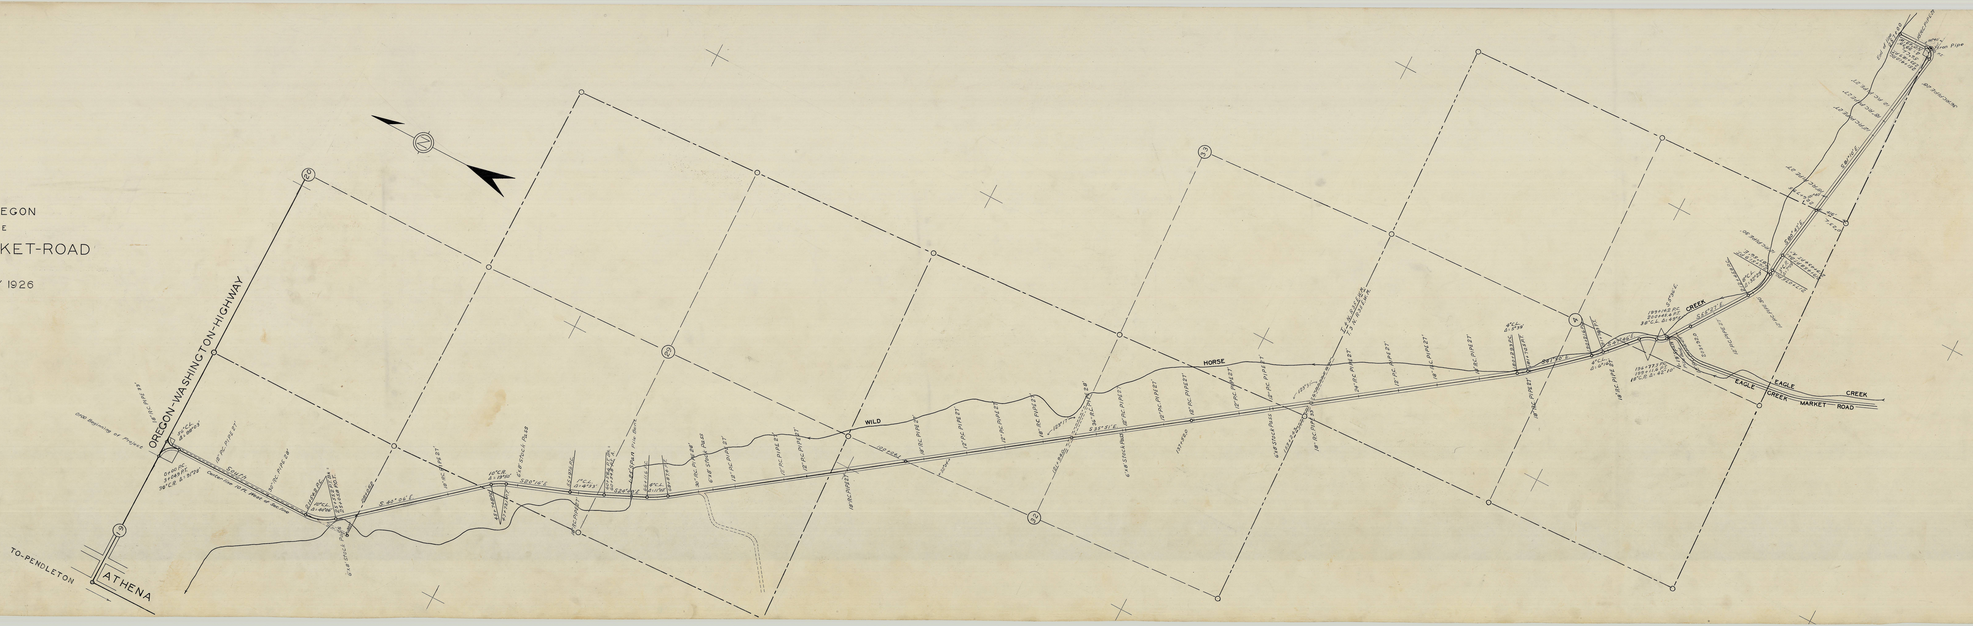
SCALE 1IN.=400FT. MAY 1926