

## Report, Survey and Plat of Road from Criglers

to

Weston Road.

To the Honorable County Court of Wasatcha County Oregon

In the matter of the location of a County Road commencing at the S. E. corner of A. J. Criglers land claim the undersigned viewers beg leave to report as follows, to wit:

We find the road to be 5 1/2 miles long it will take considerable work to open it up, but we believe it will when opened be of public benefit and utility we would therefore recommend the same to be established as a County Road For further particulars with regard to angles & distances we refer to the Surveyors report

J. J. Kirk

J. S. Allen

Field Notes of County Road commencing at the S. E. corner of A. J. Criglers land claim and running from thence to the Weston Road

Set a post for initial point thence


80.00	East	Set a post 1 mile
03.00	County Road leading down Camass gulch	N 32° West
26.50	2 miles	
15.00	Point of angle thence	
3	N 60° W	
35.00	Point of angle thence	
	N 70° E	
30.00	3 miles on same course	
3.00	Point of angle thence	
	N 74° E	
0.00	Point of angle thence	
	S 45° E	
3.00	Point of angle thence	
	S 62° E	
7.50	Point of angle thence	
	S 74° E	
16.00	Point of angle thence	
	East	
6.00	Point of angle thence	
	N 45° E	
9.00	Point of angle thence	
	N 77° E	
15.00	Point of angle thence	
	East	
12.00	4 miles thence East	
	East	
80.00	5 miles thence East	
45.00	Intersect County Road leading from Weston to Milton, Survey commenced and completed Mar 15 <sup>th</sup> 1876	

J. C. Morrow

Co Surveyor

(Plat page 17)

Plat of Road from S. E. corner of a. J.  
 Leiglers land claim to the intersection  
 of the Weston. Surveyed May 15 1876  
 J. L. Moorhouse  
 es Surveyor

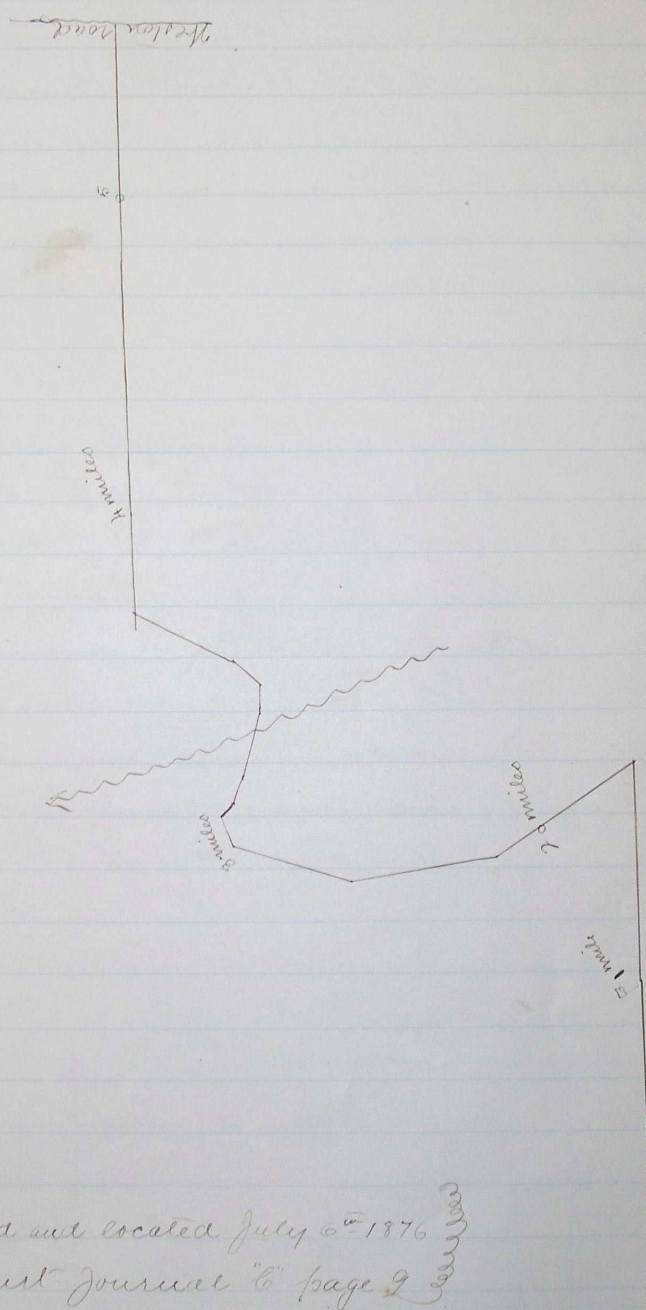

Road granted and located July 6<sup>th</sup> 1876  
 See es. Court Journal to page 9