

ROAD No
303.

Road No 303.

Report of Viewers. Field Notes^{and} Plat of Survey of a County Road
com^{ing} at Co Road running N 4 S. through Sec 16 T 4 N. R 35 E. at S. W. corner
of N. E 1/4 of Sec 16 T 4 N. R 35 E. ^{and} end at Road running from Weston to
Weston Depot.

Report of Viewers.

To the Hon. County Court for Umatilla County, State of Oregon.

We the undersigned viewers on Road Survey No 303 for Umatilla County, Oregon, would respectfully report that we met at the
time^{and} place appointed for the same, ^{and} with the County Surveyor
Jno. C. Arnold, proceeded to view out^{and} survey said road as direct-
ed by law for the same. We find the road to be upon good ground ^{and}
needed as an outlet to the town of Weston, in said County, via of O.
R & N. Co's Depot, also we find the road to be needed in hauling to
the grain platform for said Depot.

We would therefore recommend that said road, 303, be declar-
ed a public highway, ^{and} that the prayer of the petitioners for same
be granted.

James Kirkpatrick } Viewers
Boston Durr }

Field notes of Road Survey No. 303, for Umatilla Co. Or.

I met Boston Durr^{and} Jas. Kirkpatrick, viewers appointed on
Road Survey No 303 for Umatilla Co. Or., at Weston, in said County
^{and} State, on the 15th day of Nov. A. D. 1887,

Calling upon Robt Kirk^{and} A. O. Kirk to act as chain bearers ^{and}
Robt Kirk, as marker, ^{and} after qualifying, each, as required by law,
I commence at center Sec. 16 T. 4 N. R 35 E, ^{and} run East on line pur-
porting to have been E. & W. through center of said Sec 16.

(by 21° 30' E)	cas.	Set initial post in mound, about 50 links N. E. of Pt. Thence
589.20' E.	49.66	Set angle stake 6 links N. of Pt. ^{and} turn 59° Right
530.20' E.	58.90	" " " 20 " W " " " 6.10' Right
524.10' E.	80.00	" 17 mile post in mound on line, ^{and} continue on last
"		course which is parallel to ^{and} 100 feet west center of R. R. track
"	7.00	Set angle stake 10 lks. south of point ^{and} turn 37° 10' Left
561.20' E.	9.50	Intersect O. R & N. Co's R. R. track 34 chs. south of Depot.
	11.90	Set terminal post in mound on lower side of graded
		road from O. R & N. Depot to town of Weston.

For about 40 rods more than the first half mile of this road, a lane
is built, ^{and} the road is traveled; the whole road is located on good ground.

I hereby certify the foregoing Field Notes of the survey
of Road No 303 for Umatilla County, Or. to be correct.



Jno. C. Arnold
Surveyor.

rough
turn
urce
cor. on
center
d Survey

going
for Uma-
es,
veyor

Plat of Road No 303.

T 4 N. R 35 E W.M.

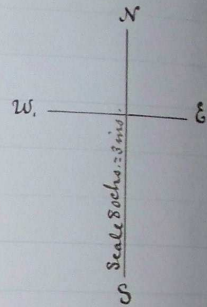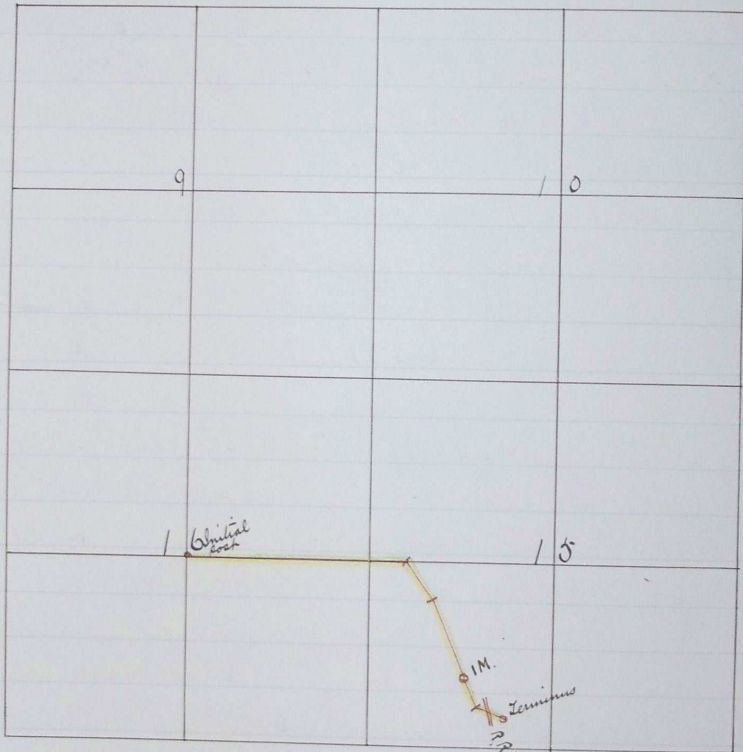

I hereby certify the following to be a correct plat of road survey 303, Township 4 N. Range 35, East of Willamette meridian, as made by me, November 15th 1887

Jno E. Arnold
Surveyor for Umatilla
County, Oregon.

Journal 9. page 626

" 9 " 707

Road Granted Jan'y 9th 1888

Recorded Jan'y 19th 1888

G. A. Hartman

Clerk

By J. H. Parkes

Deputy