

ROAD No
412.

In the matter of viewing surveying and laying out
County Road No. 412.

Commencing N. E. corner of the N. W. 1/4 of S. E. 1/4 of Sect 19
Town 4 N R 35 E running due south about 3/4 mile in a
S. easterly direction to the N E corner of the S. E. 1/4 of Sect 30
then due South on said line 1/4 mile then east about 15 rods
then South 1/4 mile to Indian Reservation line then along said
line due West about 15 rods to line between Sect 31 and 32 Town-
ship 4 N. R 35 East said Road to be 40 feet wide.

Viewers Report

To the Honorable County Court of the State of Oregon for
Umatilla County.

We, the Undersigned the Viewers heretofore appointed to view
and locate Road No 412 submit the following report.
pursuant to an order of the Honorable Court we met thro.
C. Arnold County Surveyor at Athina Oregon on December
13th 1892 and were by him each duly sworn to faithfully
and impartially discharge the duties of our appointments
We called to our aid H. M. Ritter

D. C. Stanton }
Chairman
Marker

Who were by the Surveyor each duly sworn. We viewed
Surveyed and located said Road No 412 as specified in
our order

We, find the route practicable and the road much
needed and therefore would recommend that the prayer
of said petitioners be granted and Road No 412 as
Surveyed, be declared a public highway

D. C. Stanton }
Wm Willaby } Viewers, Road Survey No. 412
J. M. Mansfield }

Filed Jan 3-1893 }
W. M. Pierce }
Clerk }

Field notes of Road Survey No. 412 for Umatilla Co. Oregon

Athens Umatilla Co. Oregon, Dec 13. 1892

I met Wm Willoughby, D. C. Stanton and Frank Mansfield Viewers on Road Survey No 412, and Qualify each as per law. We call H. M. Ritter and D. C. Stanton to chain who each Qualify after which under direction of said Viewers I find initial post, set by me July. 15 1892, in Road Survey No 385 which post is set on N. Side of E & W. lane and 40 links N. of 116 Sec. Cor on E 1/2 of line running E & W through center of Sec. 19 T. 4 N. R. 35 E. I repair Md. around the post, leaving it 4 ft base x 7 ft high and cut R 412 on S. face. From said 116 Sec. Cor. I run along center of narrow lane, course N + S, through center of Sec 1/4 Sec 19.

- South ^{Set} 1950 A house (Ely) brass E about 80 ft. dist.
- 2430 N. end of bridge across Wild horse Creek course West.
- 3524 Set A.P. Mk. 1 on N. driven even with surface, in sandy bottom, 70 ft. N. of Cor. of fence S. + S. E. thence I run
- S52° 21' E 4345 Along traveled road up creek, to bridge 70 long across W. H. Creek, course about North.
- 4427 A.P. Mk. 2, driven even with surface, in R. thence
- S. 40° 51' E 4734 N. end of bridge across W. H. CK. course N. E. } ascend
- 4814 S " " " " " " }
- 4987 A.P. Mk. 3, about 6 ft E of trav R House brass } about 175 dist, thence I run,
- S. 15° 21' E 5280 Set 1 M.P. 70 ft. S. or E. of line. Continue course ascend,
- 154 A.P. Mk. 4, Int. line bet Sects 29 + 30, thence along said line
- South 477 This 1/4 Sec. Cor. bet. Secs. 29 + 30
- 1000 Summit
- 1803 A.P. Mk. 5, Cor fencing N + E, thence along fence,
- East 2056 " " 6, thence along road in lane
- South 3382 " " 7, Int. line bet. Secs 29 + 32, thence along said line
- West 3640 This Cor to Secs 29-30-31-32, finding the post at this cor

in danger from decay, I set a triangular pyramidal shaped semiginous basalt stone, marked 5 notches on E end and 1 notch on S. Size of stone 7x7x7 ins. by 11 ins. long set 20 ins. in ground 30 ft. S. W. of this post I set terminal post in Road Survey No 412. All the posts are regulation, as per law, in size, marks, mounds + C.

I hereby certify that the foregoing are the correct field notes of Road Survey No 412 for Umatilla County Oregon

Jno. C. Arnold
Co Surveyor


Filed Jan 3. 1893
W. H. Pierce
Clerk

Plat of Road Survey No 412

I hereby certify the following to be a correct plat of the Road Survey No 412 Township 4 N Range 35 East of Willamette Meridian as made by me, Dec. 13th 1892

Jno. C. Arnold

Surveyor for Umatilla County Oregon

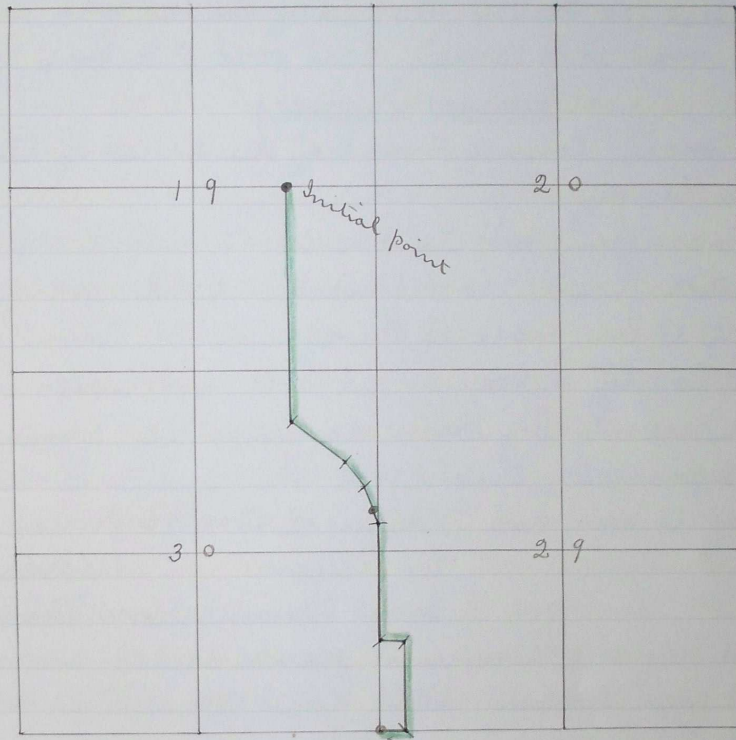

Filed Jan'y 3, 1893	} 403
W. W. Bisco	
Clerk	

gon

field Views
 De call H.
 after which
 set by me
 N. Side
 running
 around the
 S. face.
 Course

West.
 sandy
 on
 ong across
 thines
 around

ascend,
 ong said line

nce,
 said line
 this cor
 shaped
 notch on
 ground
 y No 412
 nds & C.
 iled notes

gon