


UMATILLA COUNTY
 COUNTY ENGINEERS OFFICE
WILD HORSE-MARKET ROAD
 CONSTRUCTED LINE
 SCALE 1 IN. = 400 FT. AUGUST 1925.

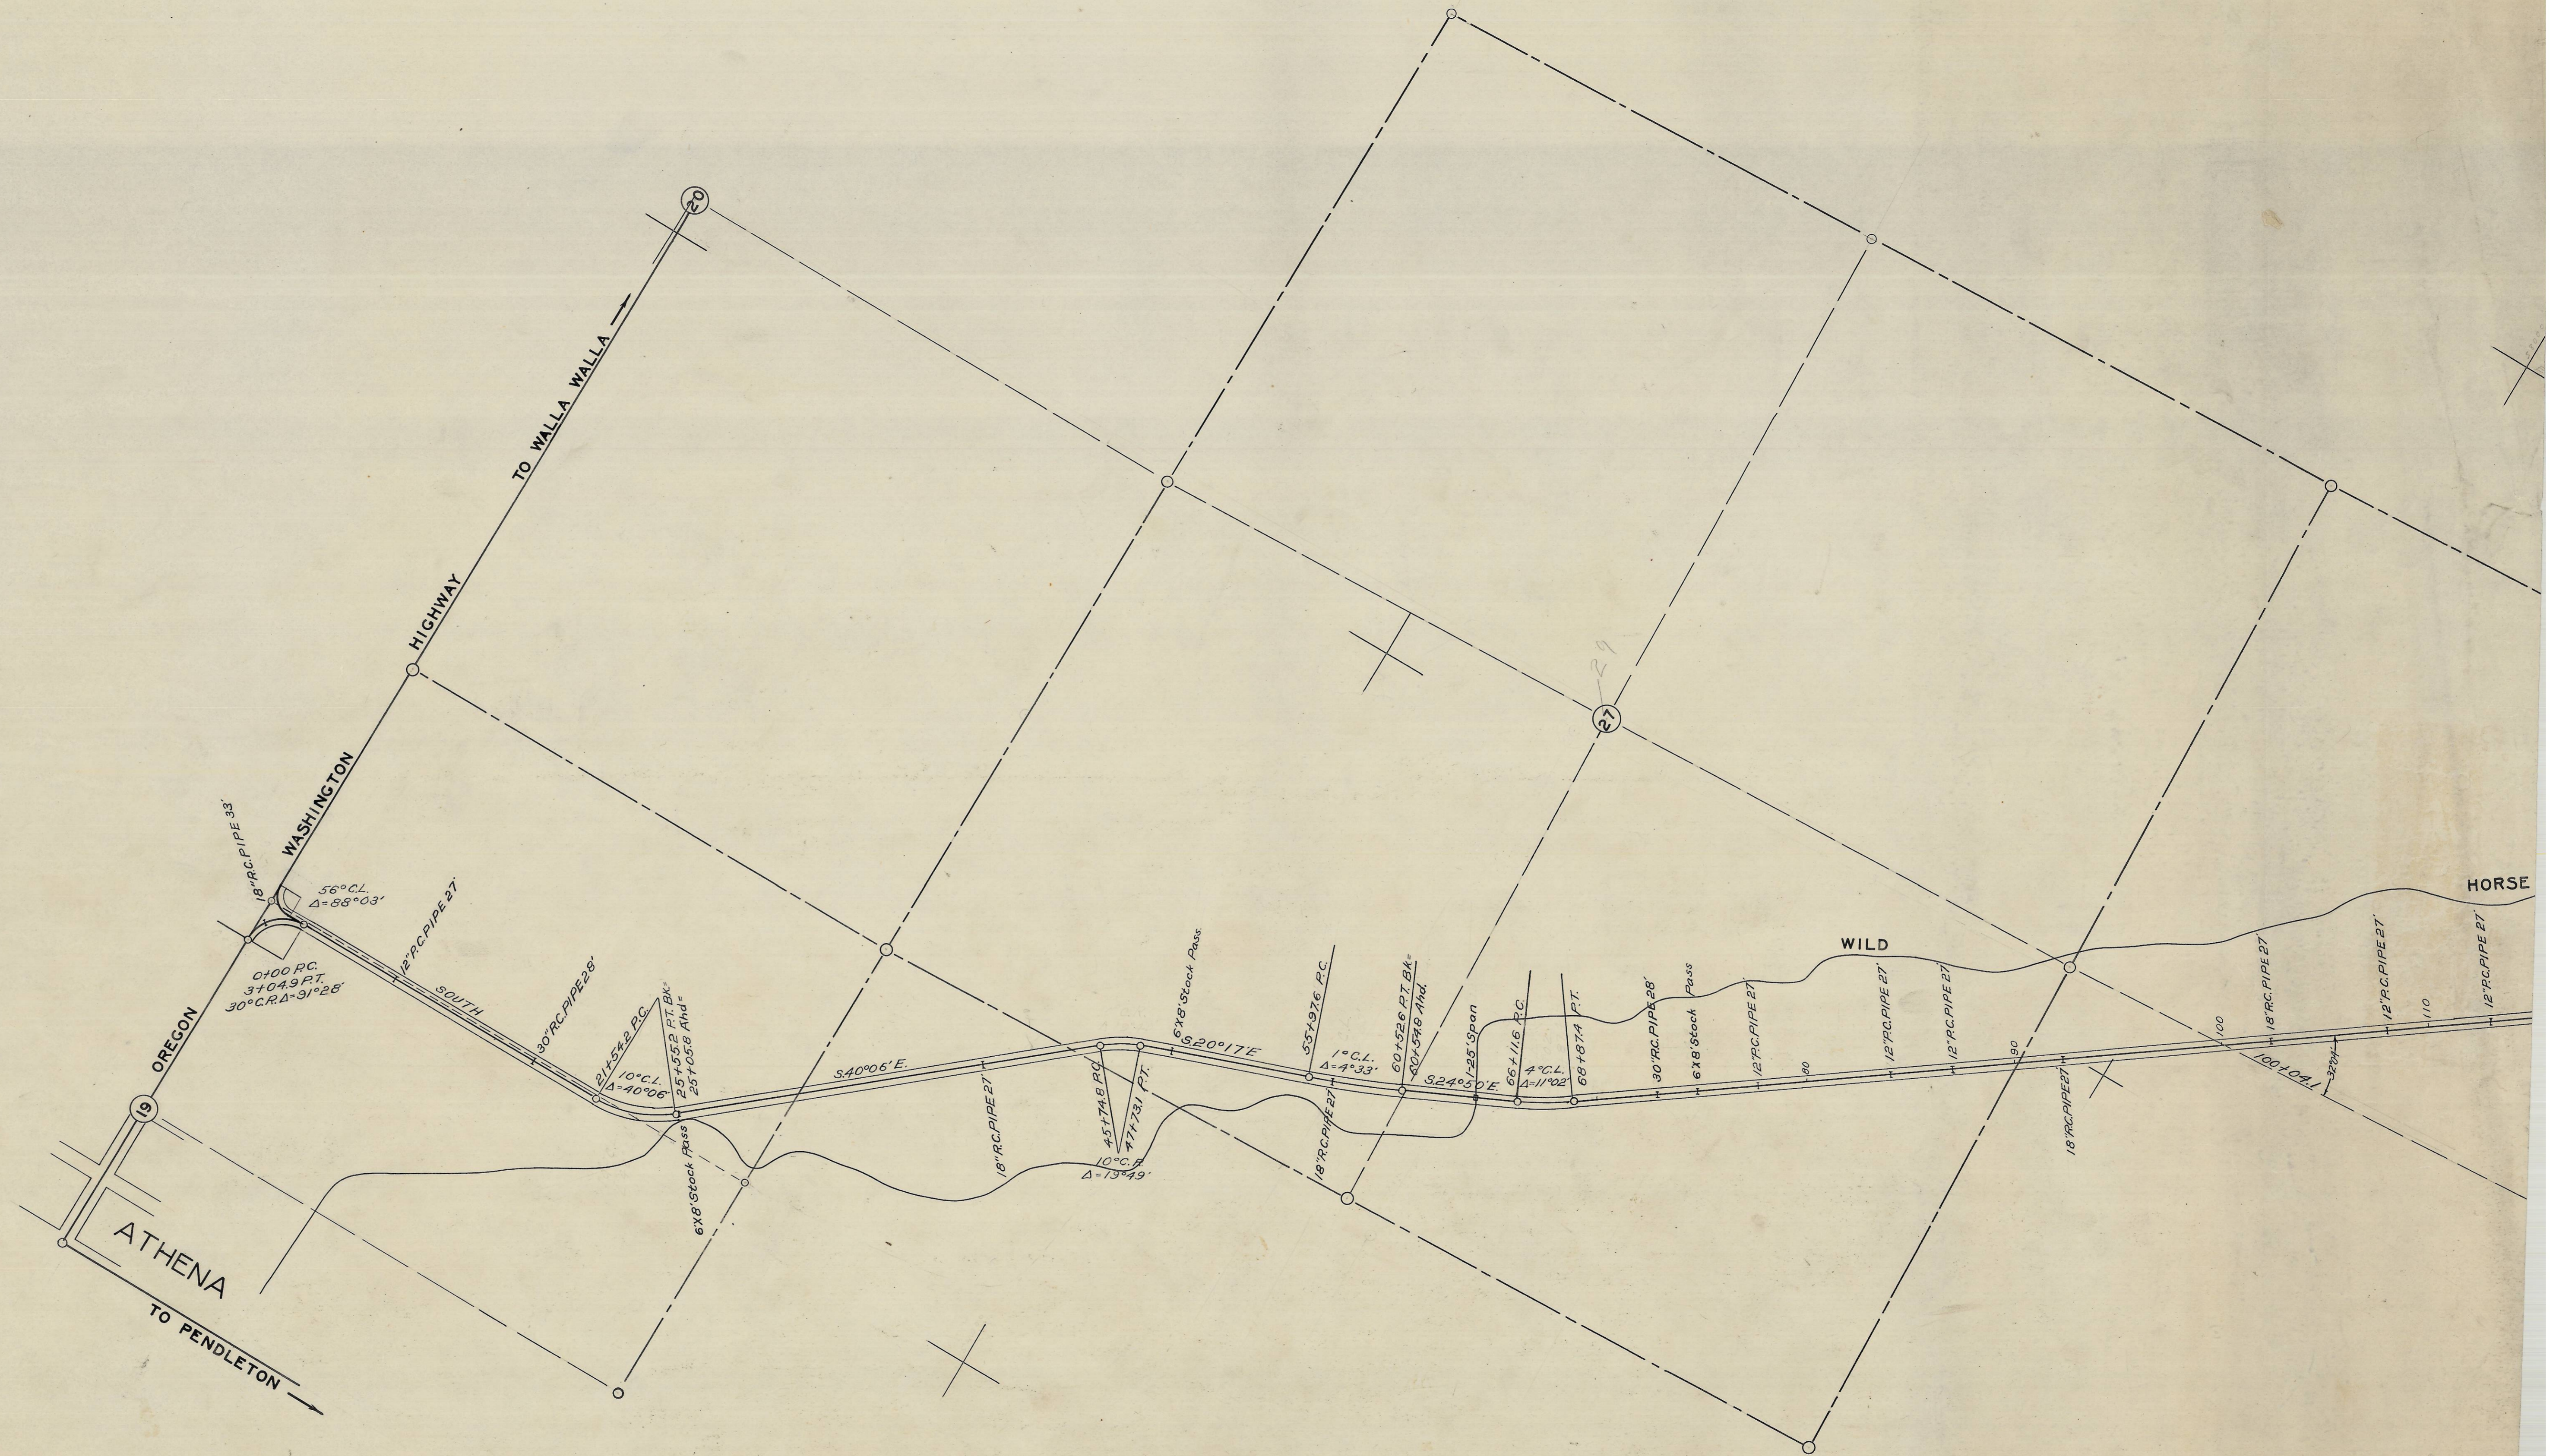

Box 2