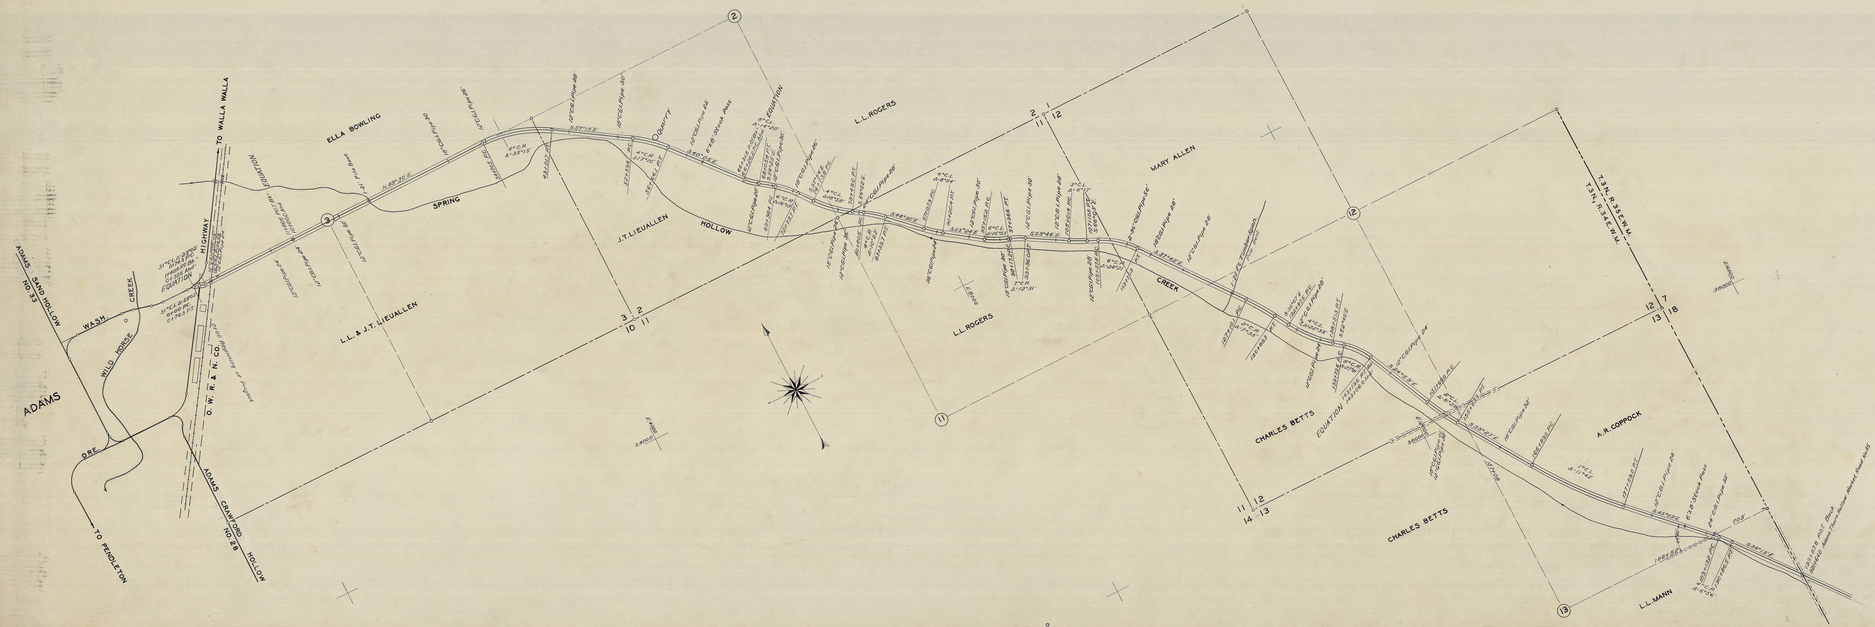

UMATILLA COUNTY

COUNTY ENGINEER'S OFFICE

ADAMS-SPRING HOLLOW MARKET ROAD

CONSTRUCTED LINE

SCALE 1 IN.= 400 FT. JULY 1925

NO.23