OREGON STATE HIGHWAY DEPARTMENT

OREGON — WASHINGTON HIGHWAY

CONSTRUCTED LINE

ATHENA-WASHINGTON STATE LINE

UMATILLA COUNTY
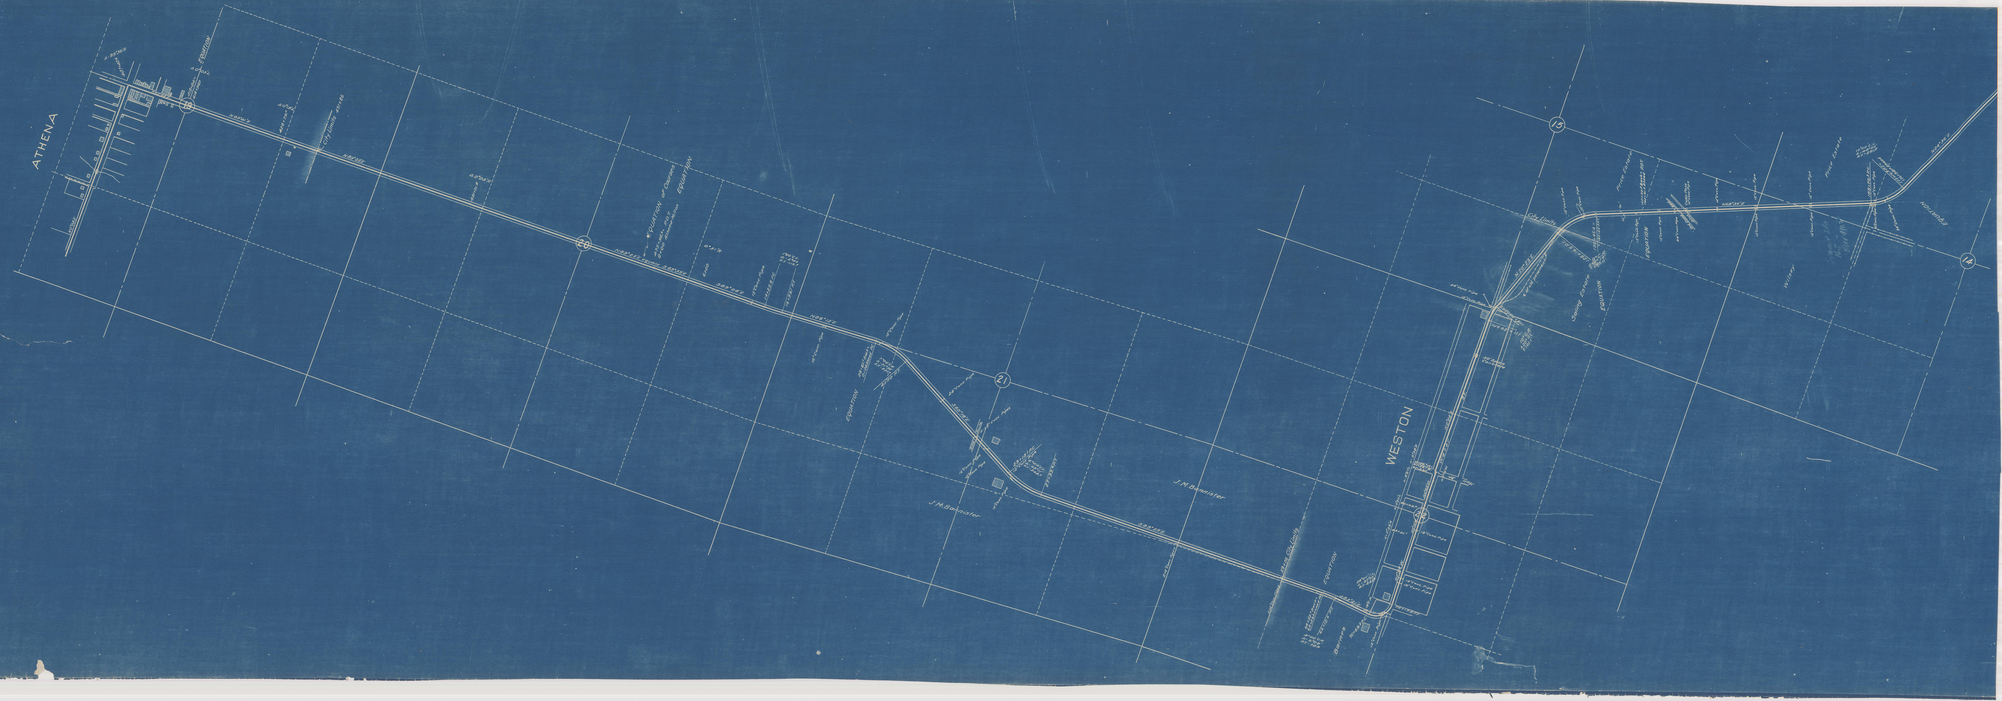
Scale 1 in. = 400 ft. May 1922