

ROAD NO
328.

in Road No 328m

Report of Viewers, field notes and plat of Survey of County Road No 328 in Umatilla County, Oregon
 Commencing at the North East corner of the
 North West quarter of Section 26 T 5 N.R. 33 E.w.m.
 running thence Westerly as near the North line of
 the above mentioned land as practicable for a
 good road to a point on said line North of the
 North West corner of the house of Ben Lasey
 thence in a North Westerly and Westerly direction
 down Vansycle location along or near the route
 of the old road which runs along the foot of the
 North side of the Bluff to a point on the West line of
 the North East quarter of Sec 22 T 5 N.R 33 E.w.m.
 intersected by the said old Road, thence North
 along the above mentioned West line to the Water
 Course of Vansycle location, thence North Easterly
 about 20 rods to a stake marked W, at the track
 of the O.W. & R.R. thence across said track, thence
 Northwesterly parallel with said track to the East
 line of Section 16 T 5 N.R 33 E.w.m. thence along
 the present route across the said track to the intersec-
 tion of road No 313 near Vansycle School House.

Viewers Report Road No 328m

To the Hon. County Court
 for Umatilla County Oregon

We the undersigned viewers
 on Road No 328 would respectfully report that we
 met with Jno C. Arnold County Surveyor at Butler
 on June 19th at 9 o'clock A.M. and were qualified
 each as directed by law. We called A. E. Reet and Justin
 Edward Gallagher and Farley Stewart to assist who
 were each qualified by taking usual oath of as-
 sistsants. We proceeded to view out survey and mark
 said Road as specified in the petition for the same.
 We find the road located on good ground and very
 much needed from the fact it is the only outlet
 between upper and lower Vansycle.

We would, therefore recommend that said road
 No 328 be declared a public highway.

John Coplien

N88°4'W
N2°2'

4°4'

8°8'

16°16'

1135°15'W
33°35'

N52°10'W
4°10'

N57°50'W
6°50'

7°70'

N43°45'W
78°45'

S84°00'W
80°00'

"
4°00'

N48°30'W
13°30'

North
17°00'

E88°40'E
19°40'

23°40'

Dated July 1st 1889 }
 J.W. Hartman Clerk }

Wm C Kern
W.M. Scott,

Field Notes of Road Survey No 328 Umatilla Co., Or.

Said W.C. Kern W.M. Scott and John Caplunger
viewers on Road Survey No 328 for Umatilla
County Or. at Melie in said County June 19th
A.D. 1889 at 9 o'clock A.M.

I administered the usual oath of Road viewers
to each after which we called A.B. Rest & Gallagher
to chain and A.B. Rest to mark, who were each
qualified as required by law.

I commenced Road No 328 at the $\frac{1}{4}$ Lee corbet
Sec 23 & 26 in T 5 NR 33 Eern. the initial post
is set 50 links N.E. of said cor so as to be out
of way of travel on this road. From said
 $\frac{1}{4}$ Lee cor I run on line bet Secs 23 & 26 as
above described Var 2^o

N 88° 45' W	Obs 2,00	Mouth of Ravine - 8. runs NW. As seen
	450	Summit
	8,00	Set angle post at point on line of Road turn
S 84° 50' W	16.74	" " " " "
N 35° 15' W	73.50	Ravine - 2 runs NW.
	33.18	Set angle post at point on line of Road turn
N 52° 10' W	45.16	" " " 10 links South of "
N 57° 50' W	68.92	Fence runs E.W. - cross corner of field
	71.12	Set angle post on pt on line of Road fence runs N.S. turn thence
N 48° 45' W	78.31	Intersect line E.W. through center Sec 22 said Rd Set angle post at pt on line of road in narrow lane E.W. and turn thence along said center line.
S 89° 00' W	80,00	Set 1 mile post 45 links South of Pt on line of road
"	4,34	Set angle post at pt on line of Road 6 links of E.W. fence and turn thence
N 48° 30' W	13.65	but A on N side of post in old fence N.S. on line through center said sec 22 and turn, thence, on said line
North	17.64	Water channel in Umatilla Canon - 20 runs N.E.
	1410	Set angle post at pt on Road line 2 links of N.S. ditch
C 88° 40' E	28.70	W post, position on S side of O.R. & P.R.R. track Set angle post at this pt and turn across said track

CR⁸⁰ 20 W 25.34 Set angle post at pt on Road line on S. hill side ^{and} turn
 CR⁸¹ 0.00 W 31.00 Dut line N.E.S. through center said Dec 22
 43.99 Set angle post at pt on road line and turn thence
 CR 31⁹.10 W 63.69 South - 4' runs West
 70.95 Set angle post at pt on road line and turn thence
 CR 43⁹.00 W 80.00 " 2 mile " 45 links E of pt on road line at Mr
 Directors, continue course last turn,
 CR 43⁹.00 W 319 Set angle post at pt on road line N of RR. track ^{and} turn
 CR 50⁰.10 W 12.75 Dut Sec line bet Dec 15, 16, in said 4^o
 16.10 " O. & W. T. R. R. track
 18.32 " County Road cr 313 near School House
 Set terminus & 51⁰ W 45 links so as to be off the line
 of travel

Note at 12 m Mr Farsey Stewart was engaged to
 mark the road.

I hereby certify that the foregoing Field notes
 of Road Survey cr 0328 for Ilwalla County, Or
 are correct


Filed July 1st 1889 }
 As Assistant Clerk }

John C. Arnold
 Surveyor.

I hereby Certify the following to be a correct plot of the survey of Road 328 Township 5 N. Range 33 East of Willamette Meridian as made June 19th 1889.

Jno C Arnold


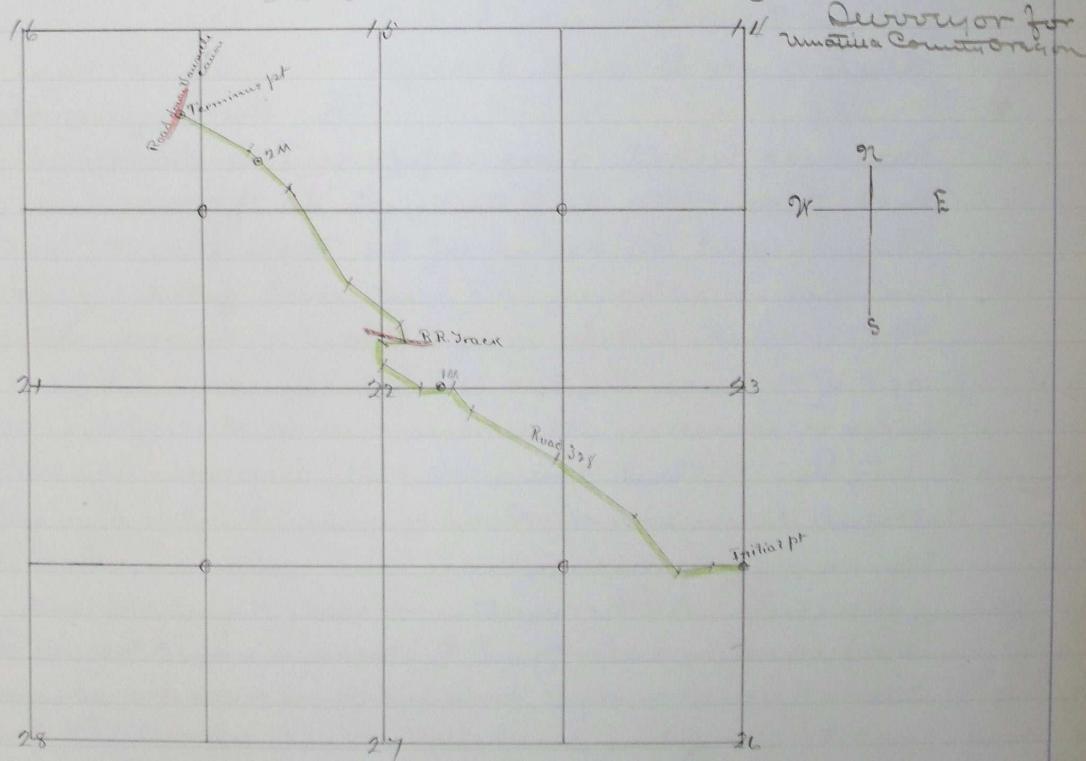

Filed July 3 - 1889 }
J. A. Martin, Clerk }
By L. W. Rosenberg, Deputy }
July 8 1890 At 596