

Viewed Report, Field Notes and Plat of Road
Commencing at the $\frac{1}{2}$ Mile post between Secs. 14 & 11
T. 5 N. R. 33 E. to Sec line between Sections 10 & 11 to $\frac{1}{2}$ Mile
post on said line.

Oregon.
We the undersigned having been appointed by your
Hon. body to view out and survey and relocate a
County Road in the above named County and State
would respectfully report that we met at the time and
place appointed, that being on the 1st Feb. and adjourn-
ed to the 2nd Feb. Met and adjourned to March 26th
Met and adjourned to April 2nd and after being quali-
fied by A. L. Coffey Deft. County Surveyor, called to our
aid W. J. Stockman, and John W. Hubert as Chairman
and E. C. Parkins as Assessor

We proceeded to view out and locate said road
Commencing at the $\frac{1}{2}$ Mile post between Secs 14 & 11 T. 5 N.
on Sec line to the Sec Corner of Sec 14 & 11, thence
west to sec line, between 10 & 11 to half mile
Stake on said line.

We would further report the road a practi-
cal one, and does not increase the distance.

We therefore would recommend that the petition
for said Road be granted.

April 2nd 1881.

Dated April 4th 1881

J. L. Kellman } Viewed.
A. H. Ramsey }
J. Reed }

County Road leading from the $\frac{1}{2}$ Mile Post, be-
tween Sec 14 & 11 T. 5 N. R. 33 E. to Sec line between
Sections 10 & 11 to $\frac{1}{2}$ Mile Post on said line.

Commenced by planting a fresh marked "R"
at $\frac{1}{2}$ Mile post on line between Sec 14 & 11, from
which we run west $\frac{1}{2}$ Mile and angle them North
40.00. Set Post marked 1 Mile 1.50 intersect Sec.
line at $\frac{1}{2}$ Mile post between Secs 10 & 11, and planted
post marked "R"

Rd #102

Shurely certfy that the above is correct.

A. L. Coffey


Deft, Surveyor of

Umanita Co. Oregon.

W. J. Stockman & John Weidert Chairmen
E. C. Partin Assman.

April 11th 1881.

mm

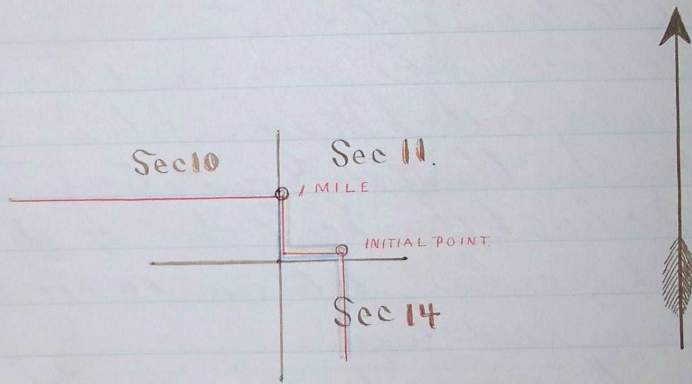

Recorded April 30th 1881. W. W. Coffey Clerk

Journal "8" Page 68.

" " " 158.