

Report of Viewers. Field Notes and Plat of Survey of a change in a
County Road leading from Gear Springs to Vansycle.
Road No 196.

Viewers Report on Road No 196.

To the Hon County Court for Umatilla County, Oregon.

We the undersigned being appointed by your Hon Body to view out a
change in a County Road leading from Gear Spring to Vansycle Road No 196.

We did meet at the time and place appointed, and viewed and surveyed
said road as set forth in the order. we find the proposed change a good
practicable route and can be opened with but little expense to the County.

We would ask that said change in said road be granted.

This the 5th day of May 1884

B. Casey } Viewers.
A. Rummy }

Field Notes of Road Survey No 196

To the Hon County Court for Umatilla County, Oregon.

I hereby certify that on the 5th day of May 1884 after qualifying messrs
B. Casey and A. Rummy as Viewers and B. Casey and Walter Caviness. Chairman,
Walter Caviness. Marker, under directions of Road Viewers above mentioned
I proceeded to survey a change in a County Road as follows:

Beginning at the center of Sec 14 Tp 5 N. R 33 E. W. M. set post marked R.
Run West 165 Rods to the 1/4 mile stake between Sec 14 & 15.
Angle thence North 160 Rods on line between Sec 14 & 15 set post, one
mile.


Run North on same line 8 Rods to intersect County Road at the
N. W. corner of Sec 14 set post M. R same Tps & R

Surveyed May 15th 1884

By W. W. Caviness,

Plat of Road No 196

Sp 5. N. R 33. E. W. M

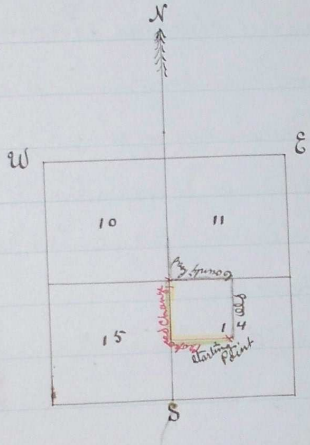

"Scale 1 inch to mile"

Journal "F" page 380
 .. "F" .. 451

I hereby certify this to be
 a true Plat of Road No 196. Surveyed
 May 5th 1884.

By W. W. Caviness.

Recorded Aug 19th 1884

J.P. Swhee
 .. Clerk