

ROAD NO  
274.

Road No 274

Report of Viewers, Field Notes and Plat of Survey of a change in County Road No 253 on the lands of G. J. Gholson and J. E. J. Kirkland.

Report of Viewers

To the Hon. County Court Umatilla County, Oregon.

We the undersigned, viewers appointed by your Hon. body, in the matter of Change in County road No 253 prayed for by G. J. Gholson and J. E. J. Kirkland would respectfully report that we met with Jno. C. Arnold, County Surveyor, at the time and place specified in our appointments and viewed out and surveyed said change as petitioned for, and we recommend that the said change, as specified in petition, be granted, for the reason that the change does not materially place the road on worse ground, or lengthen the same, and the original survey of said road 253 angled on section lines around the lands of Sassej Stewart, adjoining said premises on the west, where no more demand was made than made by your said petitioners, the original survey having been made during the absence of G. J. Gholson and the road located diagonally across his lands, whence his prayer to locate on nearest lines of legal subdivisions of the section in which he is living.

Most respectfully

William Reser  
Benj Casey  
E. E. Whiteman } Viewers

Field Notes of the survey of change in Road numbered 274.

Met Ben Casey, E. E. Whiteman & W<sup>m</sup> Reser, viewers at time and place appointed, and calling Adolph Eggerth and G. J. Gholson to act as chainbearers and Adolph Eggerth as marker, who were each qualified according to law, under direction of the said viewers I commenced at angle of road in lane N & W a point 80 rods east of the 1/4 Sec cor. bet Secs 23 & 26, and run, through the center of S. E. 1/4 and the center of N. E. 1/4 of said Sec. 23, in Township 5 North and range 33 East, North 15.50 3 mile post on original survey, 35.00 set cedar post 4x4 ins. 4 ft long marked on N. side in mound - original survey, turns S. E. up a ravine, ascend. 6.00 Summit, 13.00 cross head of slight draw, slightly ascend. 30.00 Main Summit level, 35.00 descend slightly, 46.10 ditch fence-line bet. Secs 14 & 23, S. & N. R 33 E. set angle stake and turned on true line East. Between Secs 14 & 23 - descend. 48.50 Ravine. Course N ascend. 51.00 Summit, 57.00 begin slight descent, 64.50 Begin more abrupt descent, 65.50 Ravine - course S. W - intersect original survey


Ascend. 66.62 Road in lane angles N 7 E - Cor for Secs 13. 14. 23 & 24  
set post. cedar marked R on W side -

Jno. C. Arnold  
Surveyor U. Co., Or.

ROAD T  
268

Plat of Road No 274.

T. 5 N. R. 33 E.

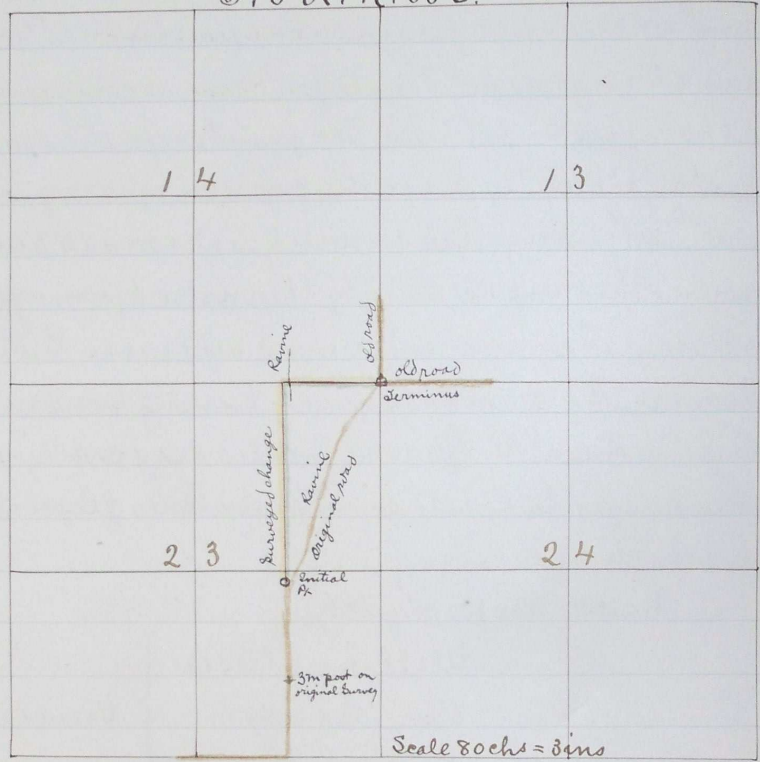

Book 9. page 344  
" 9. " 403

Recorded Oct 25<sup>th</sup> 1886  
G. Hartman  
County Clerk

I hereby certify this to be a true  
plat of Road Survey 274  
Jno. C. Arnold  
Surveyor  
U. Co. Or