

Report of Viewers. Field Notes and Plat of Survey of County Road. Commencing at the N. E. Corner of N. W/4 Sec 8 Tp 4 N. R 34 E. to connect with Co Road on the Reservation

Road No 164.

To the Hon County Court of the State of Oregon for Umatilla County.

We the undersigned viewers duly appointed by your Hon Court to view and lay out a County road commencing at the N. E. corner of the N. W/4 of Sec 8 Tp 4 N R 34 E. W. M. thence running due South 1 mile to the North line of Section 17 in said Tp. thence due East upon and along said Section line. 1/2 mile to the N. E. corner of said Section 17. thence South upon a Section line, about 2 1/4 miles to Moses Woodwards North line. thence West 60 yards. thence South 1/4 mile. thence East 60 yards to the East line of Section 29 Tp 4 Range aforesaid. thence along and upon said East line South 1/2 mile to the S. E. corner of said Section 29. thence East 1/2 mile to the N. E. corner of the N. W/4 Sec 33 said Tp. thence S. about 1 1/2 miles to the S. E. corner of the N. W/4 Section 4 Tp 3 N. R 34 E. W. M. thence E. and across Wild Horse Creek to connect with the County road upon the Umatilla Reservation running down said Wild Horse Creek.

Beq leave to report that on the 9th day of August A. D. 1883. we the undersigned said viewers met at the point of beginning of said proposed road and were duly qualified as by law required and proceeded to view and lay out said proposed road. we found the road a good practicable one and much needed and easily opened with but little cost to the County. and the line of said road is upon good ground. we called to our assistance Geo. W King & J. H. Wilson as Chaimen and F. P. Caviness as marker and we would further report that said Road is one that is much needed and will be of great utility to the whole community through which it passes.

Dated at Pendleton Oregon this 6th day of September A. D. 1883.


John Morrison
Frank Holdman

To the Hon Co Court. Umatilla Co. Oregon

I hereby certify that on the ninth day of August A. D. 1883 after qualifying Messrs Geo W. King and J. H. Wilson as Chaim bearers and F. P. Caviness. marker. under directions of Road Viewers. Frank Holdman and John Morrison. who were duly qualified as such

By D. D. East Notary Public, I proceeded to Survey of a County road for the above County & State as described in the accompanying field notes of Survey.

Commencing at the 1/4 Sec post between Sec's 5th & 8th T^p 4ⁿ. R 34^e. running South 80 chains to the 1/4 Sec post between 8 & 17. East 40 chains to the corners of Secs 8. 9. 16. 17. South 180 chains. West 3 chains. South 20 chains. East 3 chains. South 40 chains. East 40 chains. South 120 chains. East 64 chains to the County Road leading from Pendleton to Centerville along Wild Horse Creek in Umatilla Co. Oregon.
W. W. Caviness. Dept Surveyor

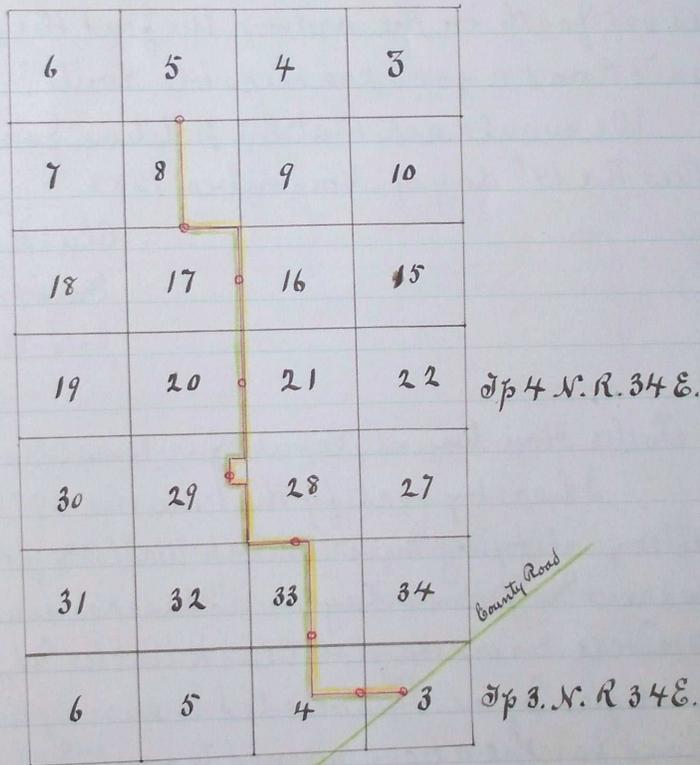

Plat of Sand Hollow Road to the Town of Adams.
W. W. Caviness,
Surveyor

Journal F. page 69
" F " 224
Recorded Feby 8th 1884

J. P. Bushee Clerk.