

ROAD No

Road No 273.

273.

Report of Viewers, Field Notes and Plat of Survey of a change in County Road in Cold Spring on the land of George Gibson.

Report of Viewers

To the Hon County Court

for Umatilla County, Or

We the undersigned viewers on a change in a County road petitioned for by George Gibson would recommend that said change be granted by your honorable body for the reasons that the change really shortens the road, while it also places it upon better ground north of the channel in middle Cold Spring, the old road following the channel in general crossing it twice.

Respectfully

A. B. Cooley

E. Hinebaugh

Field Notes of the survey of change in Cold Spring Road No 273

Met A. B. Cooley and Elliott Hinebaugh, at Res. of Geo Gibson August 16th 1886, who were each qualified to serve as viewers in the matter of changing a portion of the Cold Spring wagon Road through the premises of Geo Gibson (Sen), Geo Gibson (Jr) and Adolph Eggerth were called to act as chainbearers and Geo Gibson (Sen) as marker, each of whom was qualified according to law. Under direction of the viewers I commence at intersection of Cold Spring wagon Road with the line running N 78° through the center of Section 18 in T. 4 N. R. 32 E, which point of intersection is north 20 chs. from the 1/4 Sec. cor. bet Secs 18 & 19 T. 4 N. R. 32 E.

I run


va 0:00'

N 80° 30' W	11.39	Set angle post near traveled road - turn	20° 06' L
S 79° 30' W	17.90	do	11° 26' R
N 89° 10' W	22.53	do	4° 16' R
N 85° 00' W	38.34	do (pass 8 M post about 100 chs south)	11° 58' L
S 83° 10' W	40.28	do	10° 35' R
N 86° 15' W	49.00	Set terminus on S bank of old channel - intersect old road.	

Jno C. Arnold, Surveyor
Umatilla County, Or.

Plat of Road No 273.

D 4 N. R. 32 E

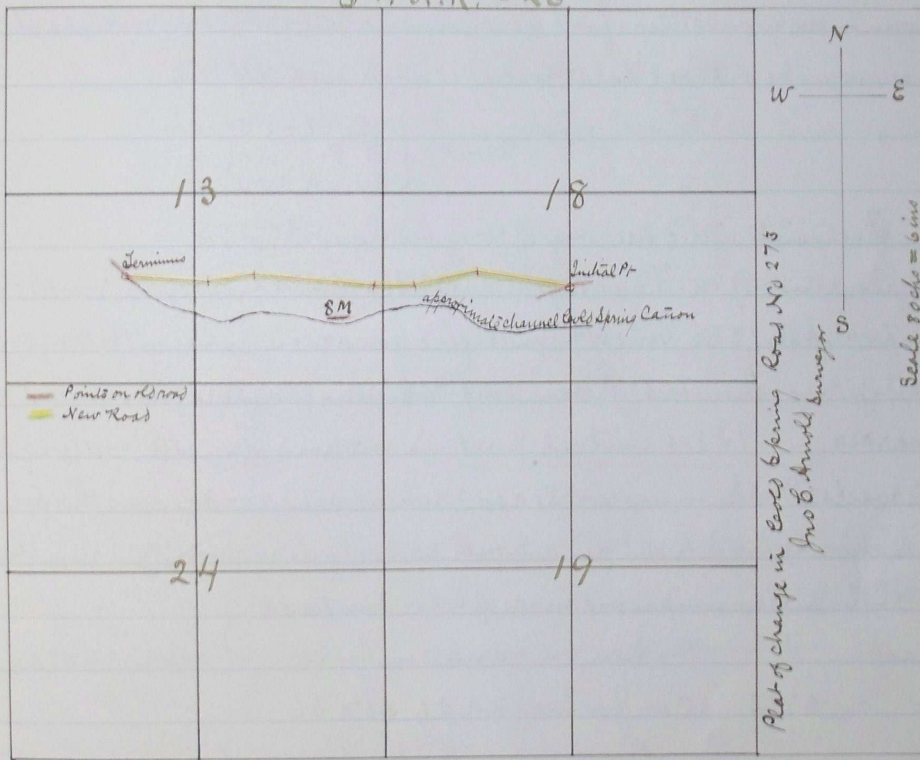

Book 9. page 474

Recorded mch 18"/1887

G. A. Hartman. Clerk

B. J. Parkes. Deputy