

ROAD No

202.

Report of Viewers. Field Notes and Plat of Survey of a change in a  
County Road on the lands of G. M. Harrah and J. F. Borsh

Road No 202.

Viewers Report

To the Hon County Court for Umatilla County, Oregon

We the undersigned being appointed by your Hon Body to view out a  
change in a County Road No 202.

We met at the time and place appointed, was qualified by W. W. Caviness  
Surveyor, we proceeded to view and survey said change as set forth in the  
order. we find the proposed change a good practicable route for a County  
Road and can be opened without any expense to the County. we would ask  
that the petition for the same granted.

This the 15<sup>th</sup> day of May 1884

Charles Ellis } Viewers  
Jonathan Haas }

Field Notes of Road No 202.

To the Hon County Court for Umatilla County, Oregon.

I hereby certify that on the 15<sup>th</sup> day of May 1884 after qualifying Charles  
Ellis and J. Haas as Viewers, John Myers and W. Caviness as Chainmen, Walter  
Caviness as marker. I proceeded to survey of a County Road for the above  
named County and State as described in the accompanying field notes.

Beginning 150 feet North of the old survey and 1/2 mile East of the West  
line of Sec 30 Tp 4 N. R 32 E. set post marked, R.

Run West 20 degrees North 180 Rods

Angle thence West 5 degrees North in Tp 4 N. R 31 E. 100 Rods.


Angle thence West 10 degrees North 40 Rods

there intersect the old survey in the S. E. 1/4 of Sec 24 set post marked One mile.

Surveyed May the 15<sup>th</sup> 1884.

By W. W. Caviness

### Plat of Road No 202.

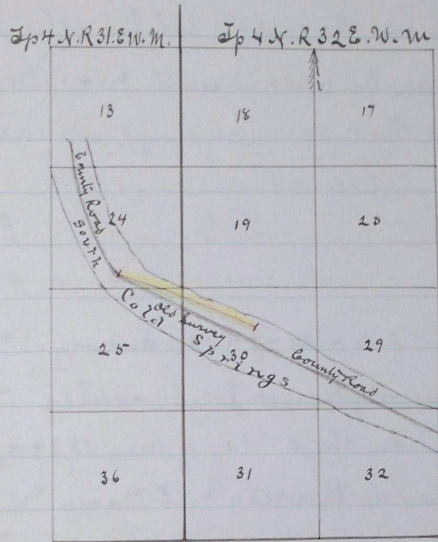

"Scale 1 inch to the mile"

A true Plat of Road No 202

Surveyed May 15<sup>th</sup> 1884.

By W. W. Caviness.

Journal "F" page 401

" " " " 456

Recorded Aug 19<sup>th</sup> 1884

J.P. Bushee

clerk.

mile.