

Rd #81

Report Field notes and Plat of  
County Road from the S.E. cor of  
Sec 30 P. 4. N. R. 34 E to middle Fork  
of Cold Spring Canyon

Rd #81

mm

To the Leon County Court  
Wematilla County Oregon. we the undersigned viewers  
appointed to view out and report on the proposed route  
for a County Road running from the S.E. cor of Sec. 30  
P. 4. N. R. 34 E to middle fork of Cold Spring Canyon  
met with J. B. Raley Surveyor as per order and after  
having carefully examined the same do most respect-  
fully recommend its adoption as a County Road at  
your next session

Thomas Kendall  
George Shurtum } viewers

Field notes

To Leon County Court Wematilla County Or  
Gentlemen I submit the following as the notes taken  
by me in the survey of County Road from S.E. cor of Sec  
30. P. 4. N. R. 34 E down South fork of Cold Spring Canyon  
met Aug 5 as per order with Geo Shurtum & Thomas  
Kendall viewers and marked Initial R on Post  
set on sec cor for commencement of Road from  
thence I run on Sec line

West	80 <sup>ch</sup>	1	set	1 mile Post. raised mound &c
"	80	2	"	" " " "
"	80	3	"	" " " "
"	80	4	"	" " " "
"	80	5	"	" " " "
"	80	6	"	" " " "
"	80	7	"	" " " "
South	80	8	"	" " " "
West	80	9	"	" " " "
"	80	10	"	" " " "
"	40		set	Post marked & run
S 80° W	11	"	"	"
N 24° W	9	"	"	"
" 61° W	6.50 <sup>ex</sup>	"	"	"
West	13	"	"	"

6781

North	ch. <sup>ex</sup> 50	11 mile Post mound &c
"	4.	set a Post
West	27.50	" " "
S 37 2/3	20.	" " "
South	12.50	" " "
West	16.	12 mile Post raised mound &c
"	24.	a Post on Sec line of 33
North	4.	" " " "
N 35° W	7.50	" " "
N 55° W	6.50	" " "
N 40° W	17.	" " "
N 30° W	22.	13 mile Post mound &c
N 30° W	61	a Post
N 53° W	19	14 mile Post
"	45	a Post
N 66° W	35.	15 mile Post " "
"	70	a Post
N 40° W	10	16 mile Post " "
"	80	a Post 17 mile Post
N 57° W	53.50	" " "
N 70° W	26.50	18 mile Post
"	28	a Post
N 65° W	52	19 mile Post
"	29.50	a Post
N 75° W	50.50	20 mile Post
"	4	a Post
N 30° W	76.	21. mile Post mound &c
"	30	angle Post
N 26° W	50	22 mile Post " "
N 26° W	68	angle Post
N 40° W	12	23 mile " " "
N 40° W	18.50	angle Post
N 50° W	61.50	24 mile Post raised mound
"	15.	Post marked R. in center of main

or middle fork of cold spring canyon the total length of Road is 24.5 miles + 15 chains  
 J. H. Raley  
 Co Surveyor

Rd #81

4mL

"



















Middle Fork Gold Spring

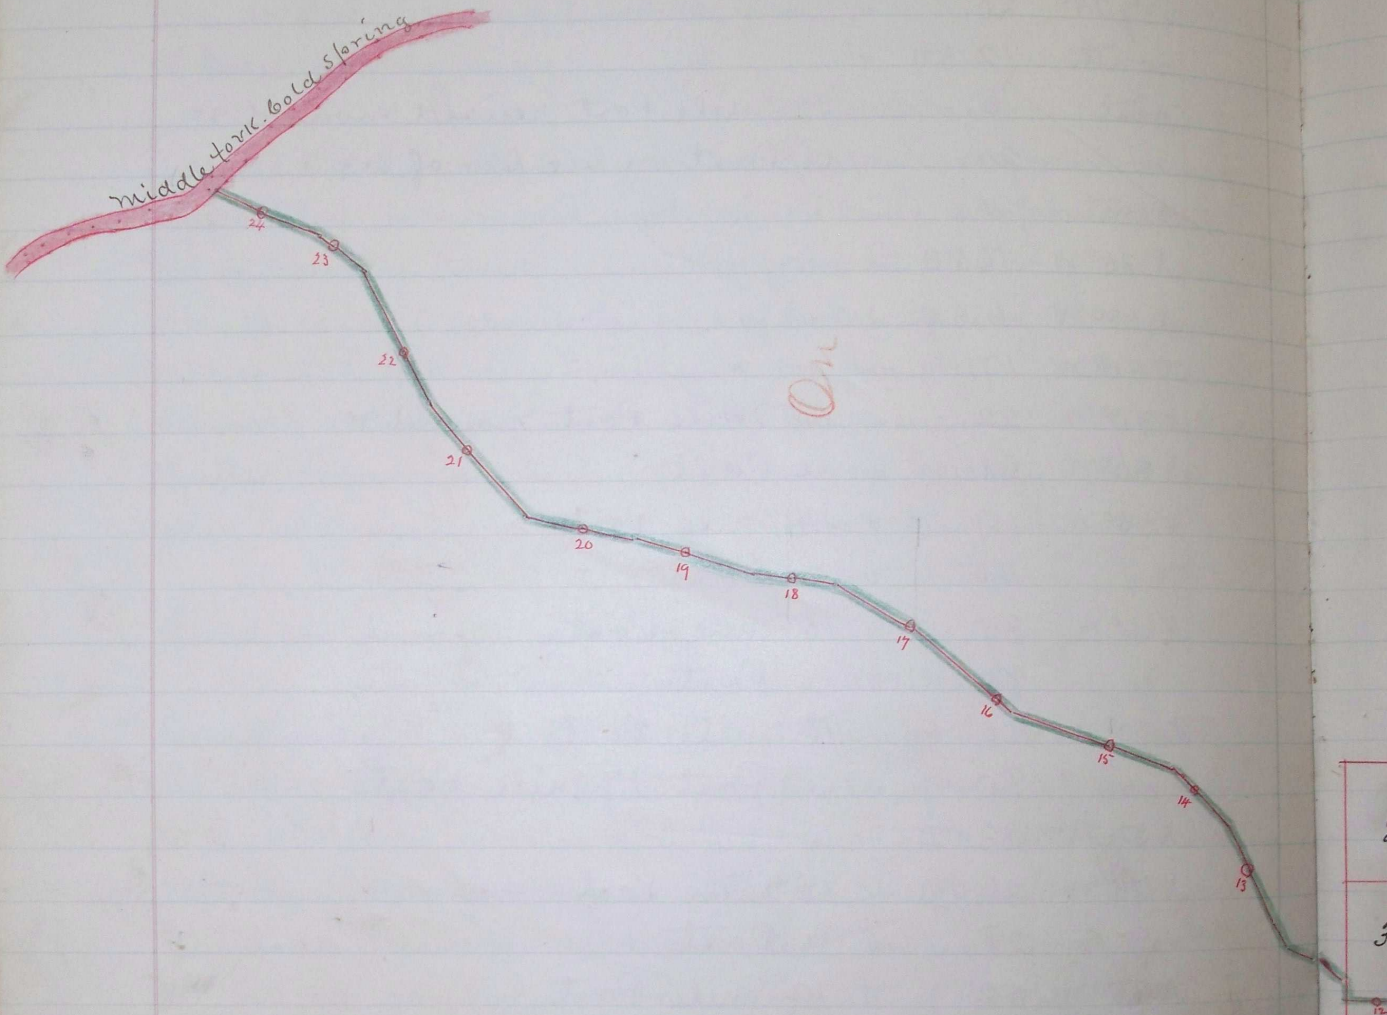

On

Rd #81

2
3
4

32 T. H. N. R. 33 East

28	27	26	25	30	29	28	27	26	25	30
33	34	35	36	31	32	33	34	35	36	31
4	3	2	1	6	5	4	3	2	1	6

Plat of Bounty Road running from S E cor  
of Sec 30. T. H. N. R. 34 East down South fork  
of Cold Spring Canyon to intersection of middle  
fork  
J. B. Raley  
Surveyor

Recorded Oct 5<sup>th</sup> 1880  
J. B. Keeney Sec. Clerk  
By M. F. White Deputy

Journal E 40