

Report of Viewers, Field Notes and Plat of Survey from the
S.W. cor of the S E 1/4 of Sec 2 T 3 N. R 33 E. to Town of Adams.
Road No 187.

Report of Viewers,

To the Hon County Court for Umatilla Co. Ogn

We the undersigned being appointed by your Honorable Body
to view out a pass for a County Road from the 1/2 mile post between
Sec 2 & 11 T 4 N. R 33 E. thence to the town of Adams. Road No 187.

We met at the time and place appointed and was qualified by W.W. Caviness
Surveyor, we called to our aid Messrs Henry Caplinger and Oscar Salo
as chainbearer and Walter Caviness as marker, we did proceed to view
and survey said Road as set forth in the order, we find said Road
to be a good practicable route and much needed and can be opened with
but little expense to the County, we would ask that the petition for
the same be granted, this the 21st day of May 1884

John Morrison }
Oro Holdman } Viewers
A. M. S. Kenzie }

Field Notes of Road Survey No 187

To the Hon County Court for Umatilla County, Oregon,


I hereby certify that on the 21st day of May 1884 after qualifying
Messrs A. M. S. Kenzie, John Morrison and O. F. Holdman as Viewers, Henry
Caplinger and Oscar Salo as Chainmen, Walter Caviness as marker,
under direction of Road Viewers here mentioned, I proceeded to survey
Road No 187, as described in the accompanying field notes of Survey.

Beginning at the S.W. corner of the S. E 1/4 of Sec Two T Three N. R 33
E. W. M. set post marked R, Run East on line bet Sec 2 & 11 Sec 14 12
320 Rods, set post one mile, Run East on same line 320 Rods
set Post 2 miles in T 3 N. R 34 E. W. M. Run East on same line
320 Rods set post marked 3 miles bet. Sec 5 & 8, Run East on same
line 294 Rods to the 1/2 mile post bet Sec 4 & 9, Angle thence North on
1/2 mile line 26 Rods, set Post marked 4 miles, Run North on same
line 52 Rods, Angle thence East 60 Rods to the town of Adams in
the S. E 1/4 of Sec 4 T 3 N. R 34 E. set post marked R.

Surveyed this the 21st day of May 1884

By W. W. Caviness.

Plat of Road Survey No. 187.

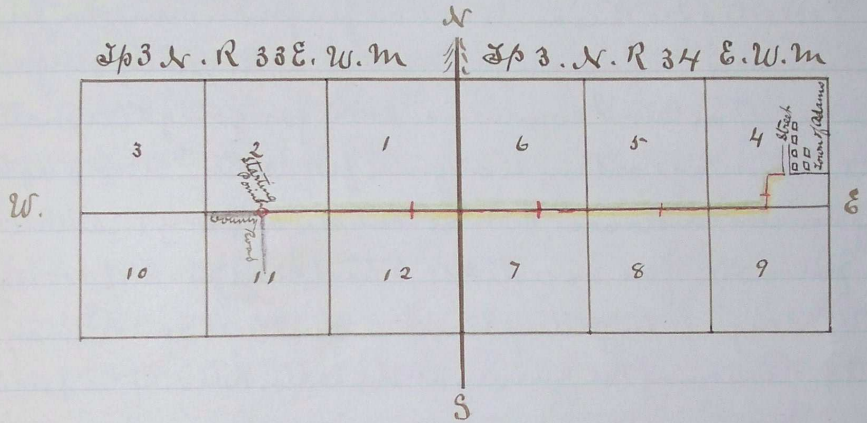

Journal F. page 384
 " F " 422

I hereby certify that this is a
 true Plat of Road Survey made May
 21st 1884.

Recorded Oct 20th 1884

By. W. W. Caviness
 Surveyor.

J. P. Bushee Clerk

Index here