158

Rd #30-A

Report. Plat. & field Notes of
County Road from Nile House Creek
to intersection of Pendleton & Weston Road

Set post marked Row bank of Nile House Creek from thence North on Sec line between
17 + 18 T. 3 North R. 34 E. 31.50 chains Set a Post

| | | | |
|---|---|---|---|
| Thence North | 48.50 | " | " M. " 1 |
| " " | 80.00 | " | " " " 2 |
| " " | 80.00 | " | " " " 3 |
| " " | 72.00 | " | " "a" " |
| " East | 8.00 | " | " M " 4 |
| " " | 80.00 | " | " " " 5 |
| " " | 78.00 | " | " R " for terminus at intersection of |

Pendleton & Weston Road

A. E. Brance
Special Deputy

33 E. 34 E.

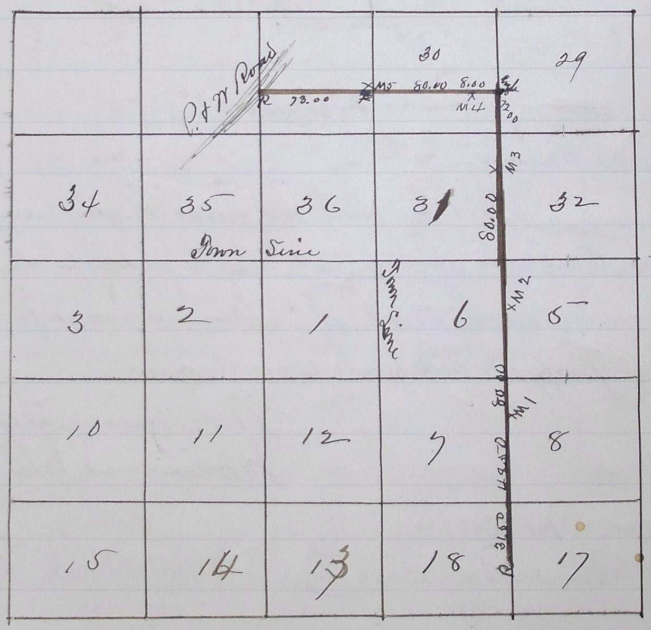


4 N

W 0

3 N

Journal D 385

Aug 27th 1879

This is to Certify that we ~~have~~ the viewers have examined the Road described as
follows Commencing at Nile House as prayed for in petition & running to the Pendleton &
Weston Road & find it to be practicable.

A. B. Rathbone
S. M. Mansfield

Located & granted Sept 6th 1879
Filed Sept 6th Recorded Sept 12th 1879