

Survey Report, Field Notes, and Plan of Road Running from N.E. Corner of S.E. 1/4 of Sec 25 T5-NR32 E, down Juniper Canyon to Columbia River.

Respan Ranch Columbia River  
March 9<sup>th</sup> 82.

To  
The County Court,  
Hematella County Or Gentlemen

We the Undersigned Viewers appointed to view and locate a county road from the N.E. cor of the S.E. 1/4 of Sec 25 T5-NR32 E, down Juniper Canyon to Columbia River - by leave to report, as follows:

Met as per order, at place of beginning, and after being duly qualified by J. W. Raley County Surveyor, called to our assistance, as Chairman W. M. Scott and S. C. Hopkins and Wm. Hanson as a jury, and after having viewed and examined said route to recommend it as a practicable and needful one as a county road.

Field April 5<sup>th</sup> 1882.

J. M. Mumfolt

Wm. Scott

M. C. Smith

S. C. Hopkins

} Viewers

Field Notes

Notes taken in the Survey of Road running from N.E. Corner of S.E. 1/4 of Sec 25 T5-NR32 E, down Juniper Canyon to Columbia River.

See Post Marked B on above described corner from which

Draw

West	80	Chains	set	I	mile	post
"	80	"	"	II	mile	post
"	60	"	25	links	Set	A
N 60° W	33	"	75	"	"	A
N 45° W	40	"	"	"	III	mile post
"	10	"	"	"	"	A
N 20° W	22	"	"	"	"	A
" 45° W	40	"	"	"	"	A
" 25° W	6	"	"	"	"	A
North	2	"	"	"	IV	mile post
N. 60° West	22	"	25	"	"	A

Rd #118

1  
 3  
 4  
 3  
 2  
 3  
N 25 H	21	chain	25 links	set	A
N 80 H	11	"	50	"	A
N 33 H	10	"	—	"	A
N 50 H	16	"	—	"	V mile Post
N 50 H	20	"	—	"	A Post
N 40 H	31	"	"	"	" "
N 65 H	16	"	50	"	A Post
N 85 H	13	"	—	"	VI mile fork
N 85 H	11	"	—	"	A Post
N 64 H	20	"	25	"	A Post
N 80 H	11	"	25	"	A Post
N 70 H	37	"	50	"	VII mile Post
" " H	16	"	50	"	A Post
N 75 H	18	"	50	"	A Post
N 50 H	16	"	50	"	A Post
N 25 H	13	"	50	"	A Post
N 62 H	15	"	—	"	VIII mile Post
N 20 H	62	"	50	"	A Post
N 75 H	17	"	50	"	IX mile Post
" " "	20	"	—	"	A Post
S 80 H	20	"	50	"	A Post
S 50 H	21	"	—	"	A Post
N 75 H	18	"	50	"	X mile Post
" " "	26	"	50	"	A Post
N 80 H	19	"	50	"	A Post
N 65 H	34	"	—	"	XI mile Post
S 75 H	15	"	50	"	A Post
N 30 H	19	"	—	"	A Post
S 85 H	25	"	—	"	A Post
N 62 H	10	"	—	"	A Post
N 89 H	10	"	50	"	XII mile Post
N 89 H	80	"	—	"	XIII mile Post
" " "	34	"	50	"	A Post
S 63 H	15	"	50	"	A Post
S 35 H	13	"	50	"	A Post
S 85 H	17	"	50	"	XIV mile Post
S 85 H	2	"	50	"	A Post
S 80 H	46	"	50	"	A Post

80  
 S 7  
 S 5  
 N 6  
 N 6  
 S 8  
 N 6  
 N 6  
 N 7  
 N 11

40. 418  
 S 76 H 20 Chains — links six A Post  
 S 54 H 11 " — " " XV M Post  
 N 35 H 10 " — " " A Post  
 N 65 H 55 " — " " A Post  
 S 85 H 12 " 50 " " A Posts  
 N 65 H 2 " 50 " " XVI M Post  
 N 65 H 80 " — " " XVII M Post  
 N 76 H 80 " — " " XVIII M Post  
 N 17 H 7 " Elk Post Marked R on bank of Columbia  
 River for the terminus of Road

I hereby certify that the above is a true copy  
 of the original notes taken by me in the survey of  
 the above described Road.

J. R. Raley  
 County Surveyor

Pendleton Or.


March 24<sup>th</sup> 1882.

Fred April 5<sup>th</sup> 1882.

J. W. Kenny Clerk

2885  
Pa #118

*S.*

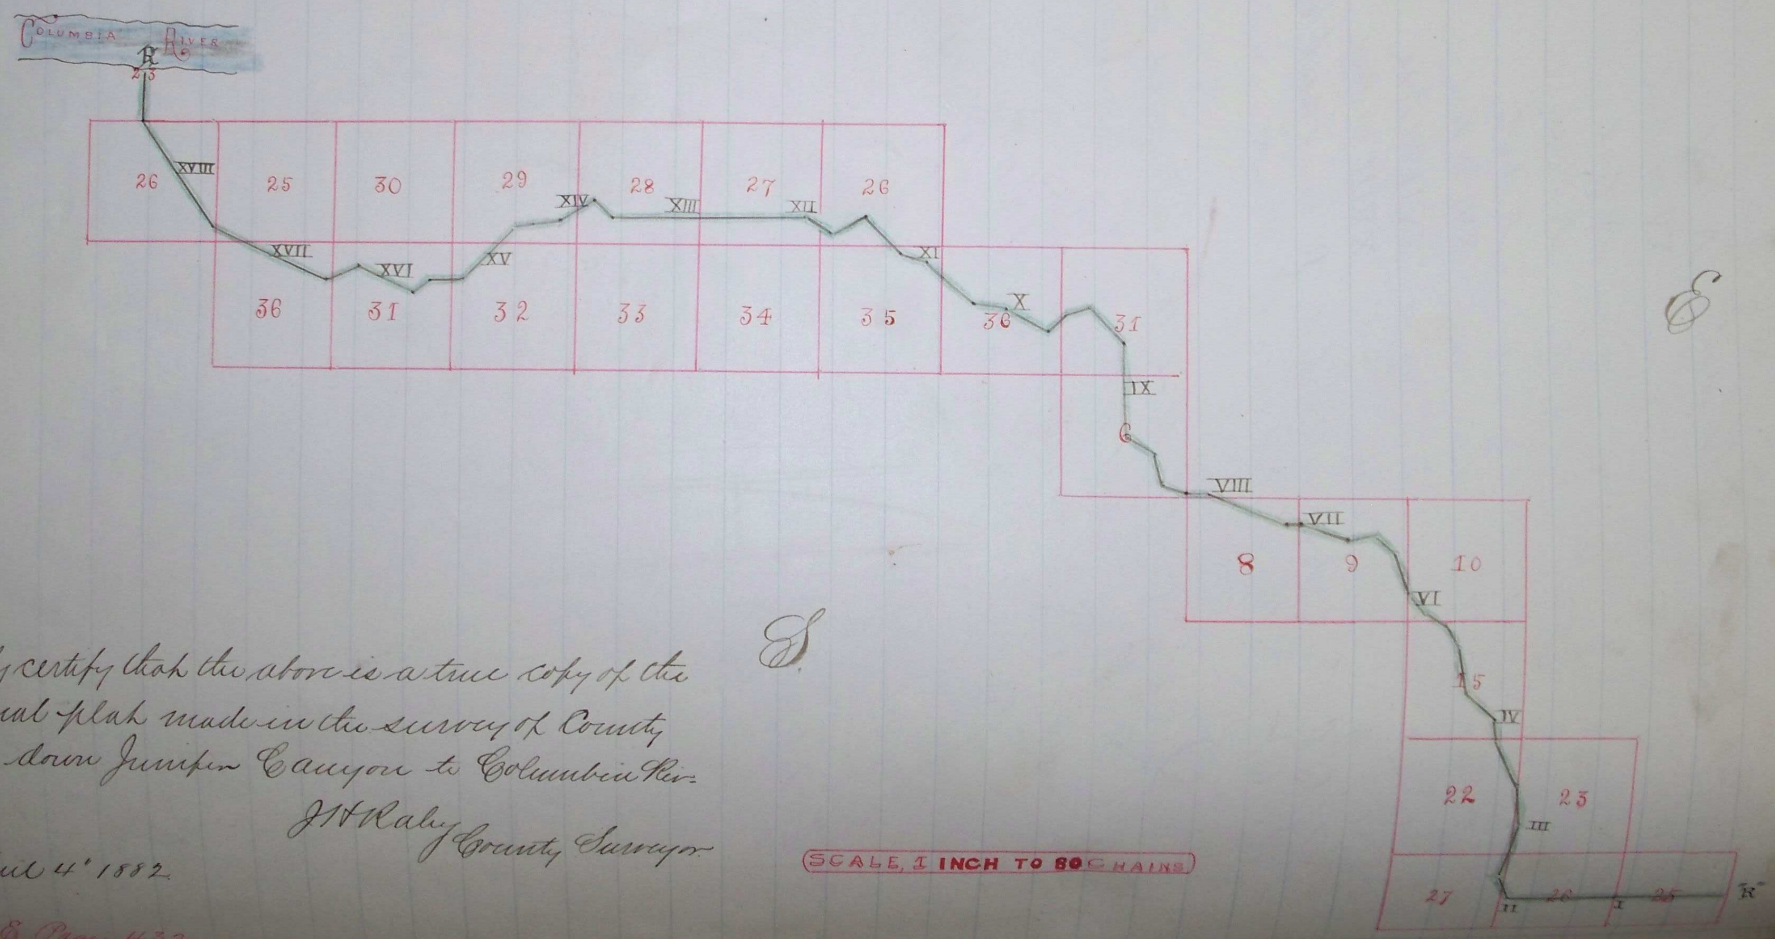

*W.*

*S.*

*S.*

I hereby certify that the above is a true copy of the original plat made in the survey of County road, down Juniper Canyon to Columbia River.  
 J. W. Raley County Surveyor

Dated April 4<sup>th</sup> 1882.

Journal B Page 432

2885  
Pa #118

2885  
Pa #118