

Road No 291.

Report of Viewers, Field Notes ^{and} Plat of Survey of Co Road. Comegat S. E. cor of SW/4 Sec 2 T⁴ N. R 33 E. ^{and} ending about 20 Rods E of the N. W. cor of SW/4 Sec 27 T⁵ N. R 33 E. ending in Big Greasewood Gulch.

Report of Viewers.

To the Hon County Court for Umatilla County, Or.

We the undersigned, viewers on county road No 291, would respectfully report that we met, Jno C. Arnold, County Surveyor at time ^{and} place appointed by your Hon. body, ^{and} proceeded to view out ^{and} survey the said road as prayed for in the petition. We find the road already opened ^{and} much traveled, it is located on good ground ^{and} will be easily kept in repair; it is much needed as a public highway, therefore we would recommend that the prayer of the petitioners be granted ^{and} the said road 291 become a county road.

J. M. Cochran }
Robert Grant } Viewers
W. R. Ammon }

Field Notes of Road Survey No 291 Umatilla Co. Or.

Met viewers W. R. Ammon, J. M. Cochran ^{and} Robt Grant at Helix May 5th 1887 ^{and} calling Jno S. Sanders ^{and} S. A. Crowell to act as chainmen ^{and} C. A. Chessman as marker, after qualifying each according to law, I commenced at 1/4 S. cor. bet. Secs 27 1 S. 4 N. R 33 E in the town of Helix Umatilla Co. Or.

Set initial post about 30 ft. N. E. of point ^{and} run thence on cur. Sec line through center of said Sec 2.

Var 21° E

North,	feet 2635	Center Sec 2, established by A. L. Coffey, Co Surveyor. Set angle stake at point ^{and} run thence on cur. Sec line through center Sec 2
West	3870	Set angle post, ^{and} run thence
N 22° 30' W	5280	Set 11 M post about 25 ft west of line, ^{and} against fence on west side of lane course N. 4 S. Continue course
	740	Cor. for Secs. 34 & 35 in T. 5 N. R 33 E. Set angle stake about 20 ft east of point ^{and} run thence on line bet. Secs 34 & 35 S. N.
North	3500	1/4 S. cor bet. Secs 34 & 35, set angle stake at angle of traveled road in lane south ^{and} west, stake set about 15 ft north of point ^{and} run thence
S 57° 30' W	5280	Set 11 M post about 20 ft N of point on west hill side
		Continue course

576 Angle of road in lane, marked by split larch post set in mound marked R on the west side - I cut A on N. side of the letter R to mark an angle, ^{and} run thence

N28°30'W 1150 Set angle post about 25 ft, east of point, ^{and} run thence

N45°00'W 2350 " " " " 30 " " " " " " " "

N29°20'W 4716 " " " " 10 " " " " " " " "


N9°46'W 5280 Set 111 M post against fence on west side of Greasewood, about 20 ft west of line ^{and} run thence

N26°40'W 1500 Intersect road in lane running west about 2 rods east from 1/4 S. cor. bet. Secs 27 & 28. set terminus post about 30 ft. west of point,

I hereby certify the foregoing to be the correct field notes of the survey of County road N^o 291.

Jno C. Arnold, County Surveyor.

Plat of Road N^o 291.

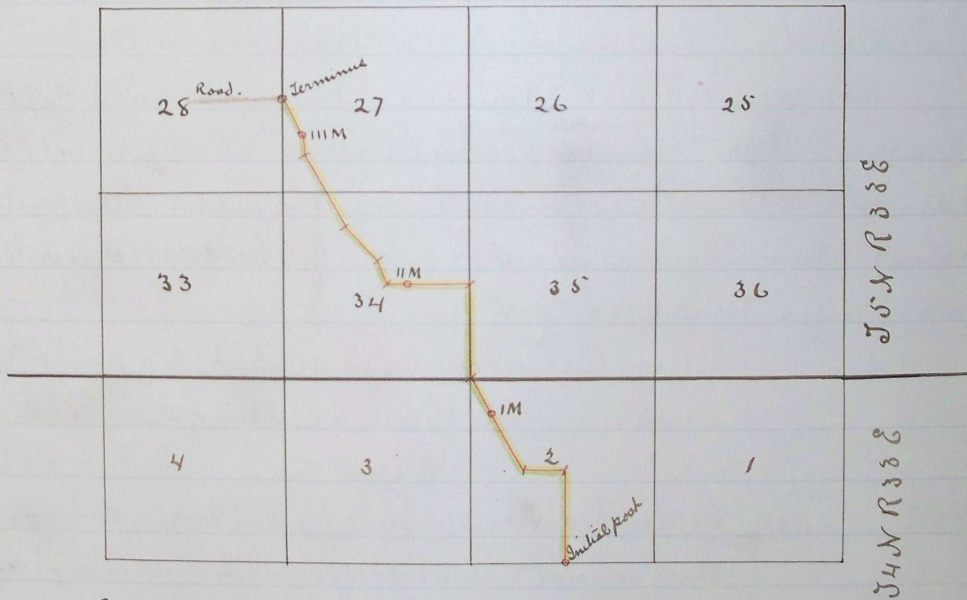

Journal G. page 526

" " " 585

Recorded Aug 5th 1887

L.A. Hartman

Clerk

By J.H. Parkes, Deputy

I hereby certify the foregoing to be a correct plat of Road Survey No 291

Jno C. Arnold

County Surveyor.