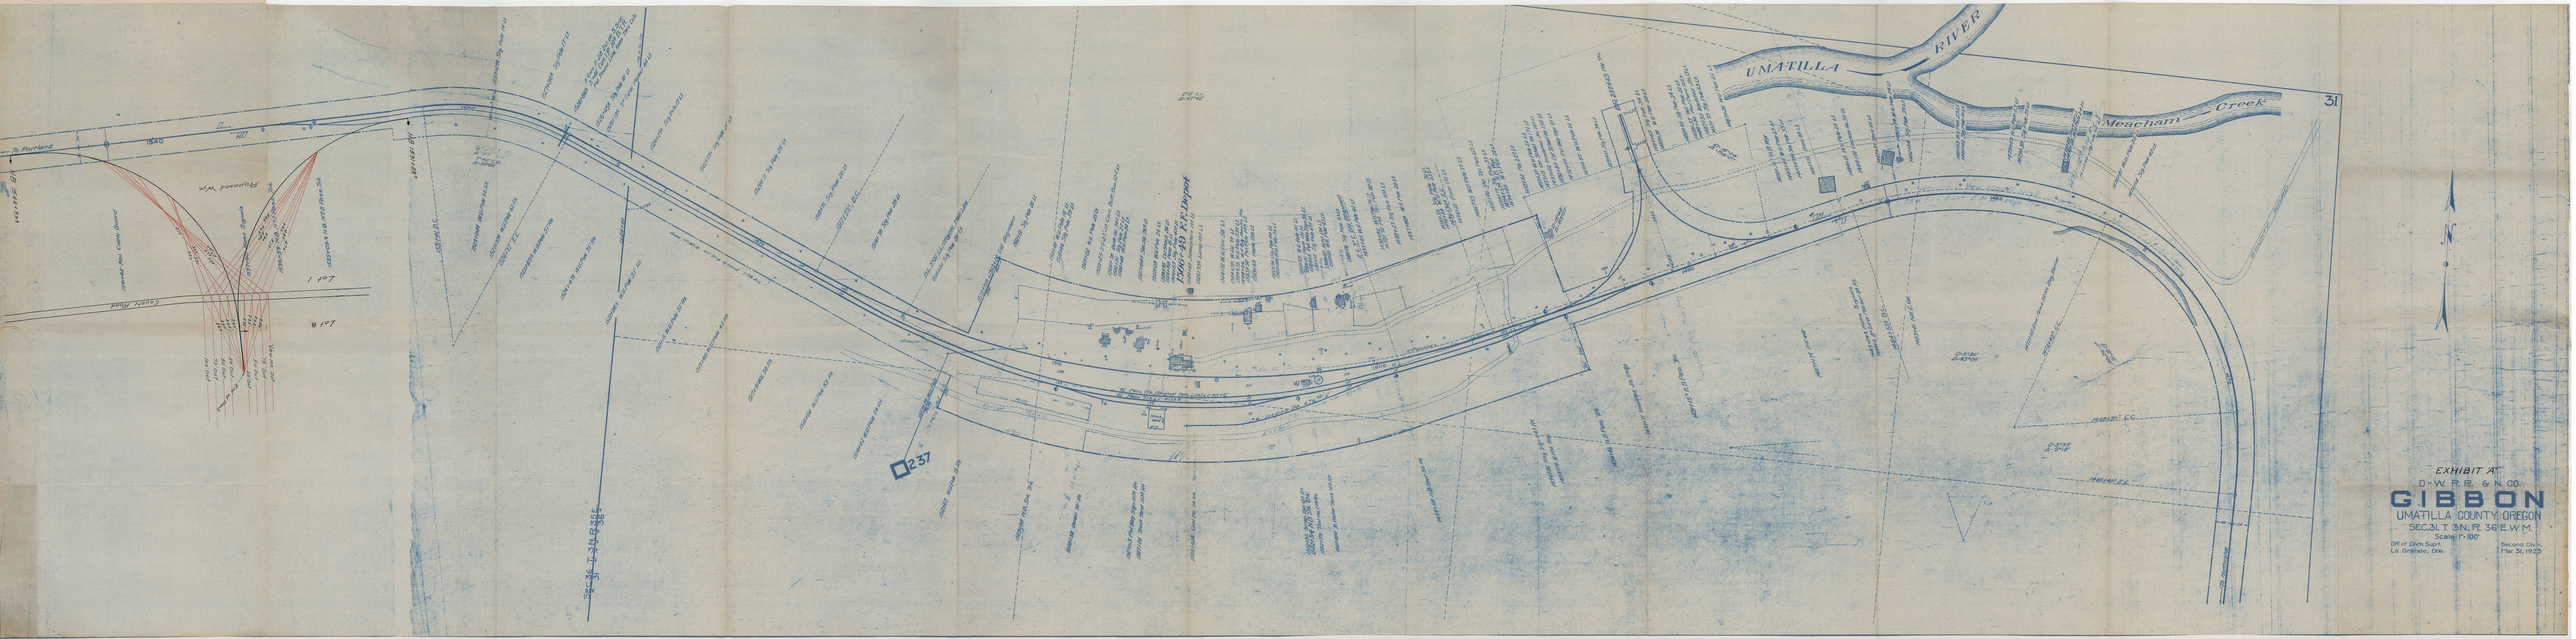
UMATILLA RIVER
Meacham Creek
31
To Portland
1540
Proposed W.R.
County Road
1 lot
9 lot
1906-09 O.R.C. Depot
237
EXHIBIT "A"
O-W. R. R. & N. CO.
GIBBON
UMATILLA COUNTY, OREGON
SEC. 31, T. 3 N., R. 36 E. W.M.
Scale: 1" = 100'
Diff. of Divn. Supt.
La Grande, Ore.
Second Divn.
Mar. 31, 1923