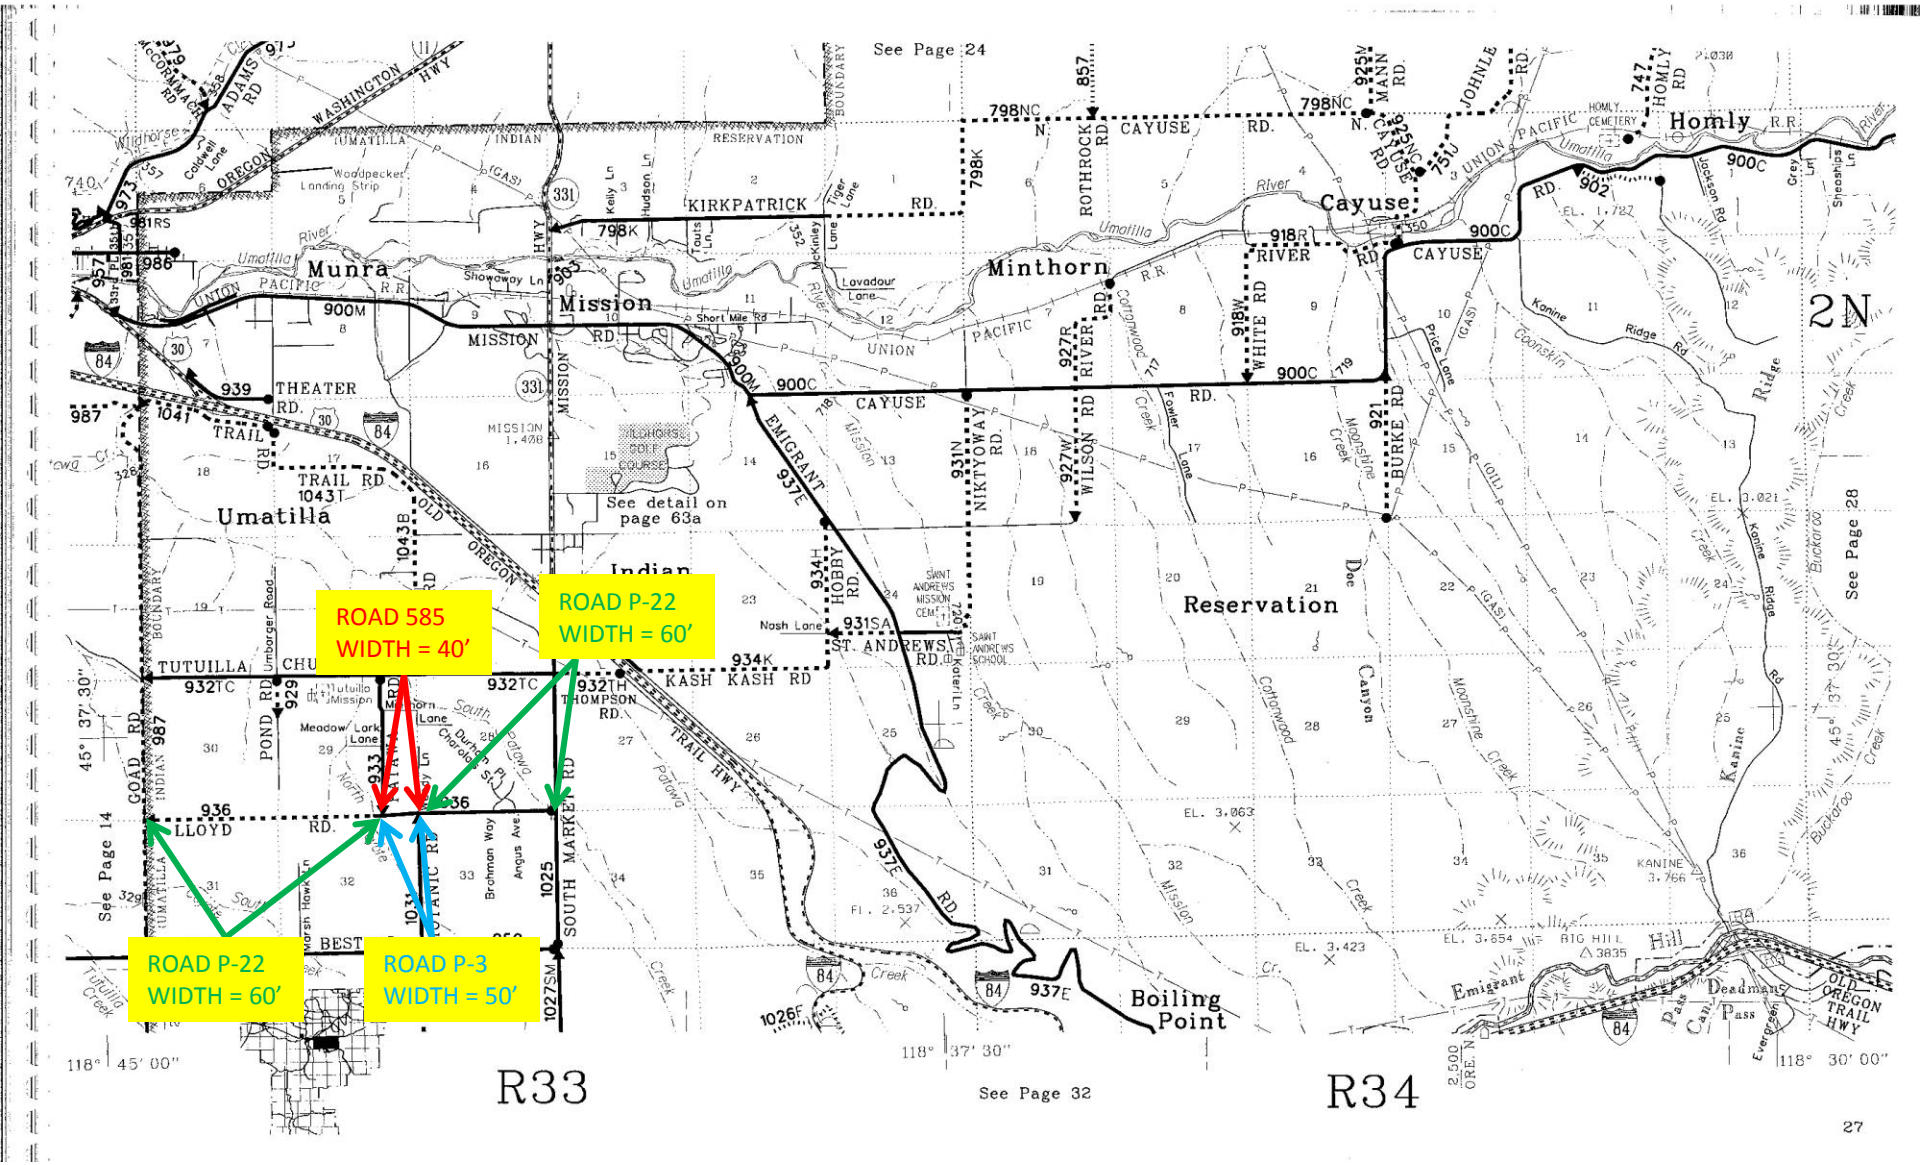
ROAD 585
WIDTH = 40'
ROAD P-22
WIDTH = 60'
ROAD P-22
WIDTH = 60'
ROAD P-3
WIDTH = 50'
See Page 24
See Page 14
See Page 28
See Page 32
See detail on page 63a
Munra
Mission
Minthorn
Cayuse
Homly
Umatilla
Indian
Reservation
Boiling Point
R33
R34
2N
27