

Notes of Survey to Vacate County Road
petitioned for by Martin Kupers Et. Al.
To the Honorable County Court)
Umatilla County , Oregon.)

I submit the following as the
notes of the survey to vacate a county road as petitioned for by
Martin Kupers Et. Al.

Began at a point 20 ft. west of the corner of Sections 15-16-
21-22 T.3 N.:R 33E.W.M. Ran thence west bet sections 16 and 21.
60.00 chains road leaves section line and turns north.
65.00 " north 2.80 chains to center line of road.
69.50 " ravine course south. 7.00 chains north to road
and two bridges over ravine.
72.00 " road again touches section line.
79.75 " cor. sections 16-17-20-21.
120.00 " intersect east line of county road running north
and south through center of sections 17-20.


I hereby certify that the above is a true copy of the notes
taken in the above entitled survey, made April 25 th. 1917.

Willard Bradley
County Surveyor.

MAP SHOWING ROAD TO BE
VACATED - PETITION OF
MARTIN KUPERS ET AL.

April 25 1917.

Willard Bradley
County Surveyor.

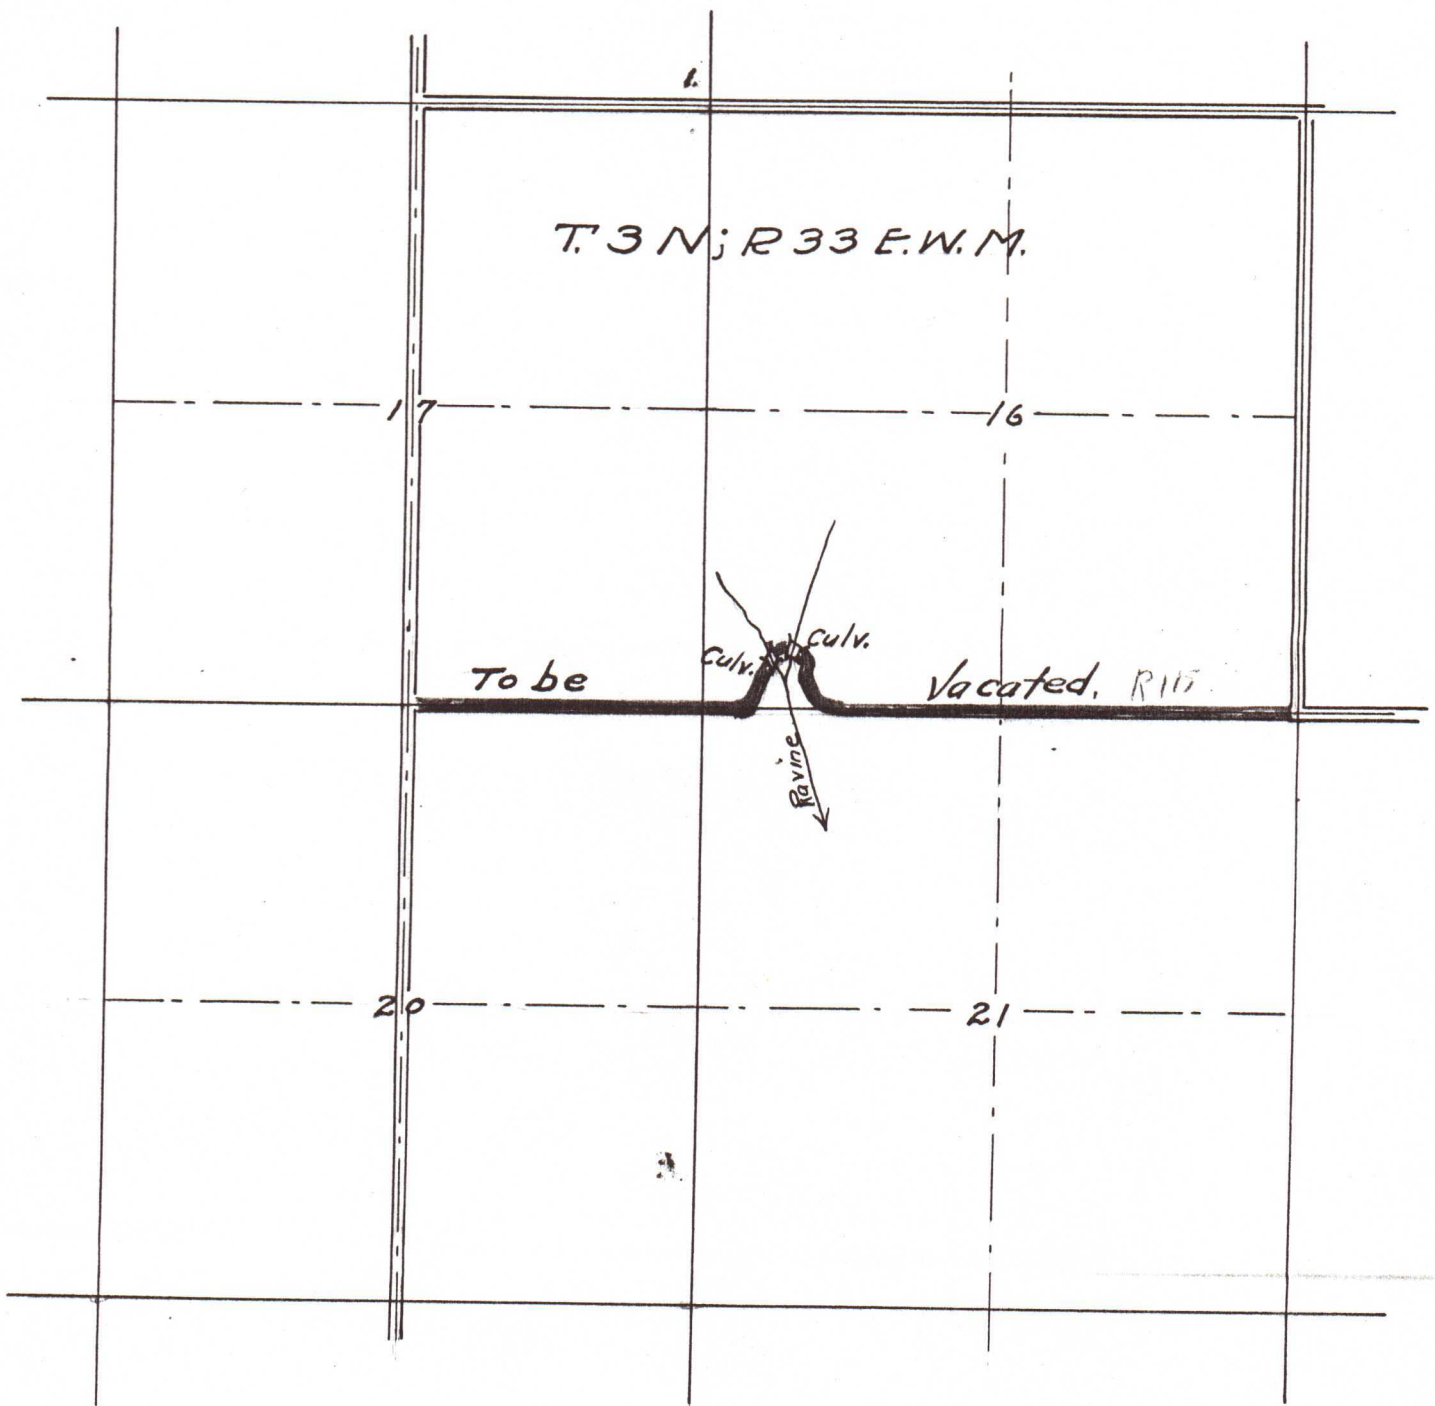

IN THE COUNTY COURT OF THE STATE OF OREGON
FOR UMATILLA COUNTY

IN THE MATTER OF THE PETITION
OF MARTIN KUPERS ET AL FOR THE
VACATION OF A COUNTY ROAD.

Now on this day this matter coming on to be considered, upon the petition of Martin Kupers and fourteen other freeholders who are residents of the road district or road districts wherein the hereinafter described County Road which is proposed to be vacated is now established, praying this Court to cause to be vacated a certain County Road as follows: Commencing at a point on the East line of the public road running north and south through the center of sections 17, and 20, in township 3 N R33, E.W.M. in the center of the public road running east and west between said sections seventeen and twenty above described, running east for a distance of one and one half miles to a point in the center of said last mentioned public road on the west line of the public road running north and south between sections fifteen and sixteen, township 3N, R33.E.W.M.

And the Court finds that ~~three~~^{due} notices of the intended presentation of said petition has been given by the posting of three notices in the vicinity of said road which is proposed to be vacated, and also by the posting of a notice on the bulletin board at the north door of the County Court house in Pendleton, Ore., the place of holding the County Court. That each and all of said notices were duly and regularly posted in a public place and in plain view of the public, and remained so posted for more than thirty days immediately prior to the presentation of said petition to this Court. The Court further finds that said petition is duly and regularly signed by at least twelve freeholders who are residents of the road district wherein said road which is proposed to be vacated is now established, and there being no remonstrance or objec-

tions on file against said petition, it is hereby ordered that said petition be granted and that the board of County Road Viewers, towit² Willard Bradley, as surveyor, and W. J. Stockman and L. C. Rothrock as viewers be, and they are hereby ordered and instructed to meet in Pendleton, Oregon on the 25 day of April, 1917, or if unable to meet on that day, then within five days thereafter, and proceed to view survey and report upon said road, which is proposed to be vacated, and make due return of their doings to this Court at its next regular term.

County Judge

24/5/1917

} Coms.