

Report & Survey & Plat of Road Change of Newton & Puddledon Road

Rd #120

To the Hon. County Court,  

Having carefully viewed the above named road as per your Order, & having inspected the Surveyors report & Plat. we cheerfully report the change of route to be a good and practicable one & we recommend its adoption by your Hon. Body,

Respectfully

Dated. Puddledon Cr. }  
April 1<sup>st</sup> 1879 }

P. M. Coffey } Viewers  
R. Sargent }

Field notes of above road.

Plat <sup>report on</sup> Survey made in accordance with Order of Hon County Court issued Jan'y 6<sup>th</sup> 1879.

Jere Napain }  
P. M. Coffey } Viewers  
R. Sargent }  
J. H. Raley Surveyor,

Commenced work on 13<sup>th</sup> <sup>2<sup>nd</sup></sup> Completed road on 14<sup>th</sup> of March 1879. Commencing as indicated on map at N.W. Cor of S. N. 14, of Sec 33. T. 4. N. R. 34. E. & running as per map & following notes.

Course	Dist	Remarks
South	40 <sup>c</sup>	Set "A" Post
W	320 <sup>c</sup>	" Proper "M" Posts + "A" Posts
S	80 <sup>c</sup>	" "A" Post
W	160 <sup>c</sup>	" "M" + "A"
S	80 <sup>c</sup>	" "M" of 40 - "A" @ 80
W	120 <sup>c</sup>	" "M @ 40. "M @ 80 @ "A"
S	90 <sup>c</sup>	" "R" for termination of Road & run 10 Chains to intersection of N. boundary of Sec 19.

Increase distance on old road about 2 1/2 miles


Time employed two days

- Surveyor
- 2 Viewers
- 2 Chainmen
- axe man
- & two horse team

Yours very respectfully  
J. H. Raley  
C. Surveyor.

Rd K Rd # 20

# Plan of Change in Newton and Puddleton Road

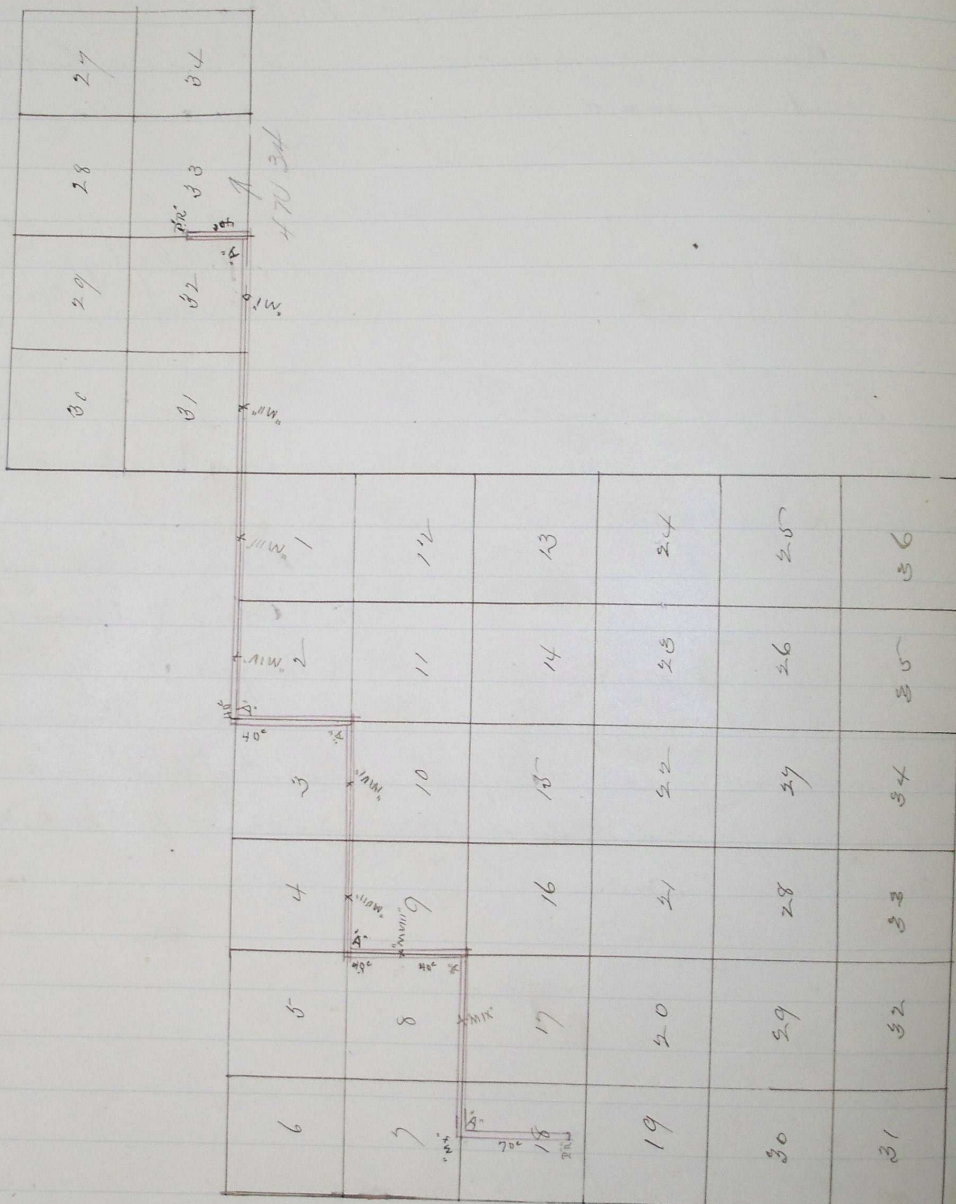

Filed April 9<sup>th</sup> 1879, and recorded May 6<sup>th</sup> 1879.

Road granted and located April 10<sup>th</sup> 1879  
 See Co Court Journal Page 329