

ROAD NO

451

In the matter of viewing, surveying and laying out County Road No 451

Commencing at the northeast corner of sec 16 in Tp. 3 N. R. 33 E. W. M. Thence running East on Sec line between Secs 9 and 16; Secs 10 and 15; and Secs 11 and 14 in said township and range, and there terminate. Said road to be 40 feet wide

Report of Viewers

We, the undersigned, the viewers heretofore appointed to view and locate County Road No 451 submit the following report: Pursuant to an order of the Honorable Court we met John W Kimbrell, Surveyor, at Geo Shutrums house on September 20th 1894, and were by him each duly sworn to faithfully and impartially discharge the duties of our appointments, and on Oct 9th 1894, we called to our aid Geary Kimbrell and J W Kimbrell, chairman, who were by the surveyor each duly sworn. We viewed, surveyed and located said road No 451 as specified in our order, and find the route practicable and very much needed as a thoroughfare, and would most respectfully recommend it be declared a public highway.

Note - I met Geo. Shutrums and John M Bahr, viewers, as per appointment Sept. the 20th 1894, who were by me duly sworn, to the Rosenberg not being present. We adjourned from time to time, viz: to Sept 25th - Sept 29 - Oct 2nd and Oct 9th, 1894, when all the viewers being present to the Rosenberg was duly sworn, and we proceeded to survey lay out and mark said County road No 451 as by law required

George Shutrums } Viewers
 O H Rosenberg } Road Survey
 John M Bahr } No 451

John W Kimbrell
 County Surveyor

Field Notes

of Proposed County Road of J J Kirk, et als No 451

I commenced at the N.W. corner of sec 16 in tp 3 N. R. 33 E. W. M. Set post four feet long and four inches square S 45° W 30 feet distant from initial point marked "X" on N.E. face, dug pits N+S. and raised mound of earth 18 inches high and four feet wide at base

Thence east on line between Secs. 9 & 16. 800 chains. Set

post four feet long and four inches square North 20 feet from point on line marked "1 M" on south face dug pits E + W and raised mound of Earth 18 inches high and 4 feet at base. Thence east on line between secs 10 + 15 50.00 chains. Set post four feet long and four inches square North 20 feet from point on line marked "2 M" on south face dug pits E + W and raised mound of Earth 18 inches high and four feet wide at base. Thence east on line between Secs 11 + 14 40.50 chains to the NE cor of the N.W. 1/4 Sec 14 in tp 3. N.R. 33 E.W.M. Set post four feet long and 4 inches square S 45° W 30 feet distant from 1/4 sec corner bet. Sec 11 + 14 marked "R.I." on N.E. face dug pits N + S and raised mound of Earth 18 inches high and four feet wide at base


October 9th 1894

John W Kimbrell
County Surveyor

Filed Oct 30th 1894

B. B. Durringtons, Clerk

Plat of Road No 451 by J. G. Kirk, et als.

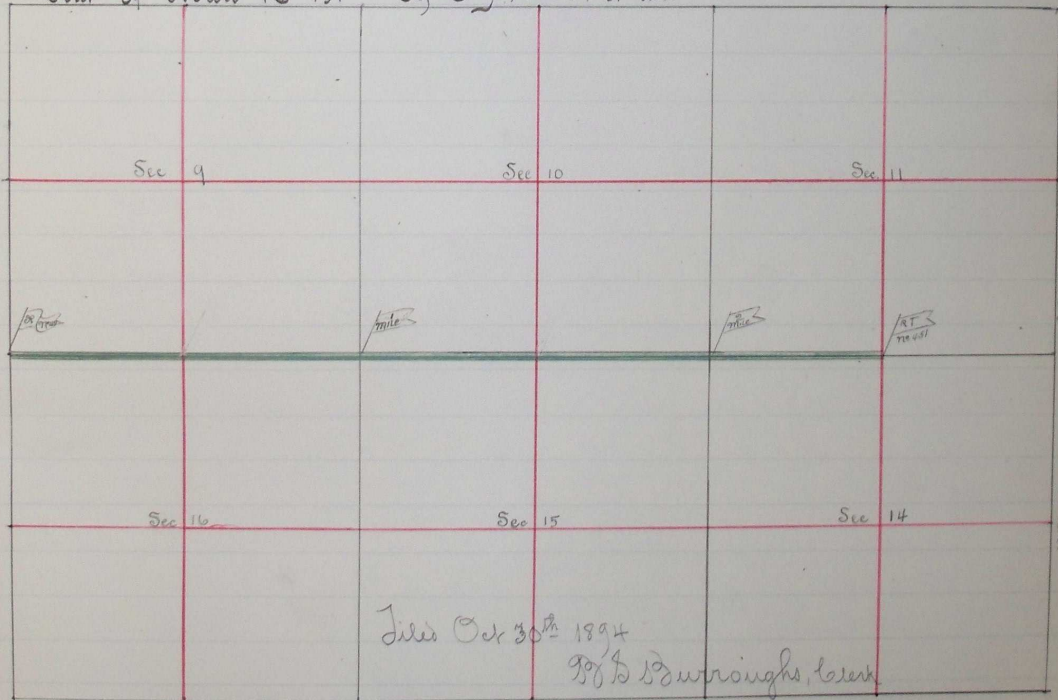

Thereby certify that the foregoing plat and field notes are correct to the best of my belief

John W Kimbrell
Co Surveyor

Nov 12 1894 J 247