


509

509

Plat of Road No. 509  
in  
T. 3 N. R. 3 E. W. 4.

Recorded in Road Plat Book  
No. 1 Page 45

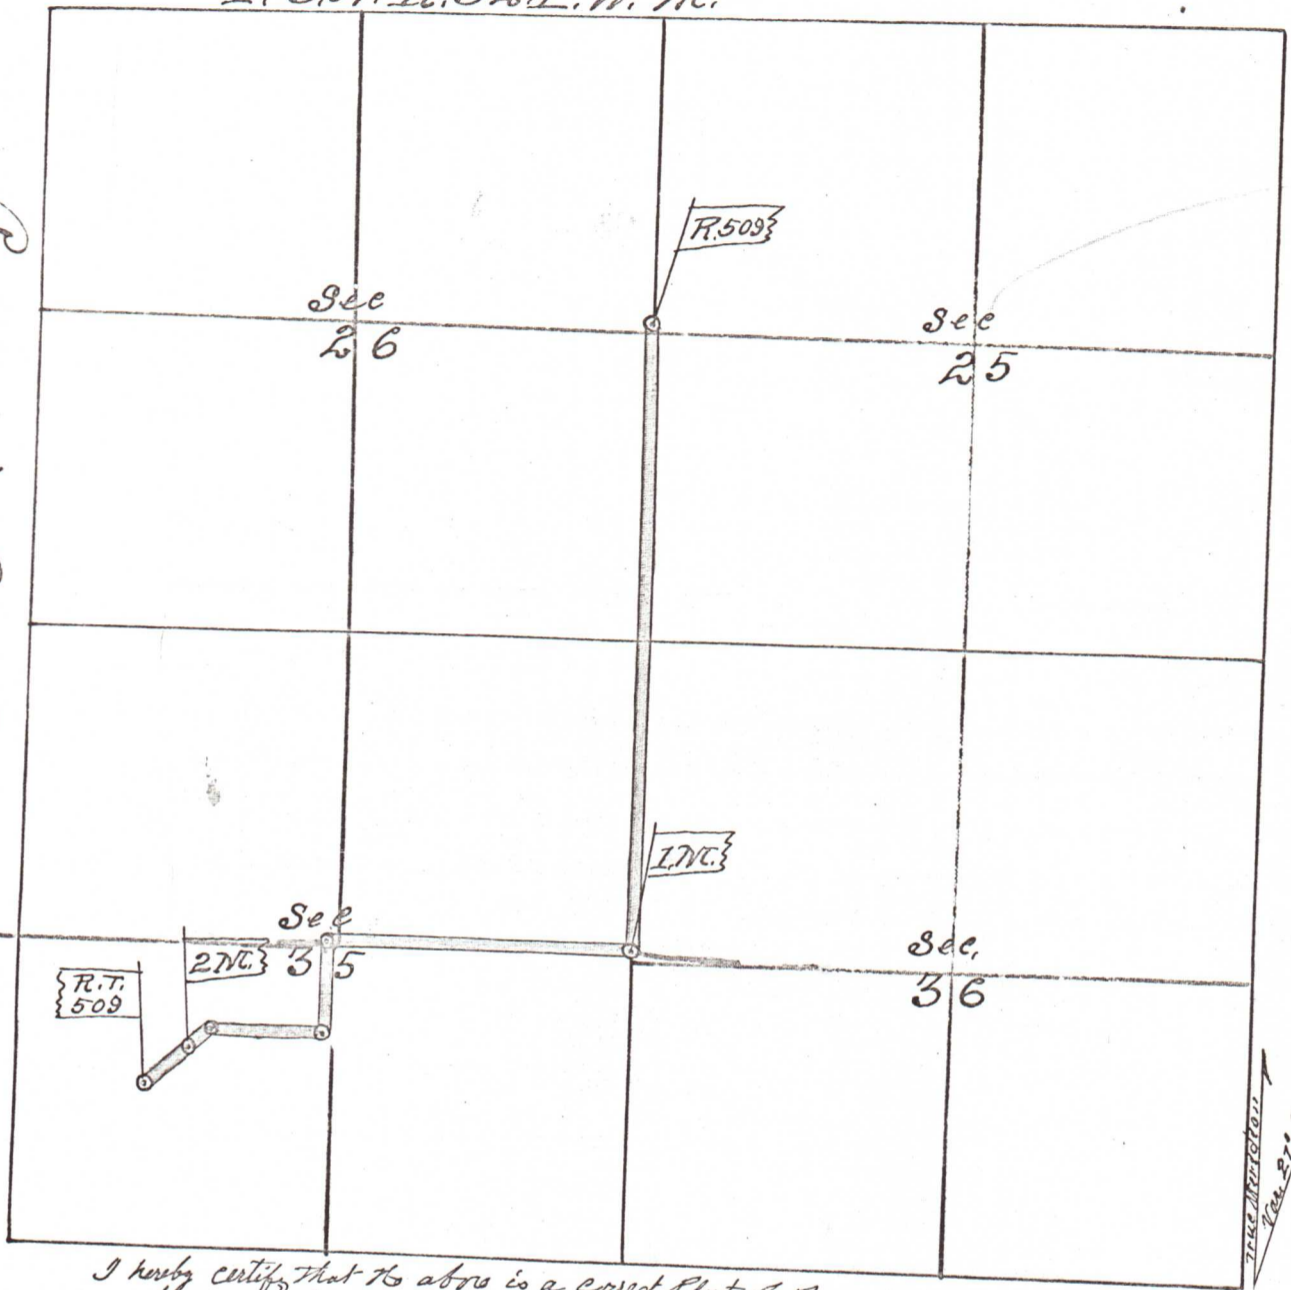

I hereby certify that the above is a correct Plat of Road No. 509  
as surveyed by me the 26<sup>th</sup> day of Aug, 1899  
John W. Kimball

County Surveyor

Scale 25 ch. = 1'