

Report. Plot + Field Notes of County Road
 Rd #1-A ~~from~~ Dry Coes Spring Canyon Road from
 Puddledon to Coes Spring Landing

To the Honorable the County Court of Ameliea County.

The undersigned viewers appointed to view & locate a road from Puddledon to Coes Spring Landing on the Columbia River. Beg leave to report that they have performed their duty according to the tenor of that appointment. & the law & find said road practical & comparatively cheaply opened. & one that we believe the necessities of the Country demand

E. Helch.

Andrew Sullivan

Field Notes.

Commencing on the Road near the S.W. Corner of Section 3. T.2. N. R. 32. E. on the north side of the Bridge out of Puddledon, thence by Courses & distances as follows to wit:

N.	38°	45'	N.	8.	47	ch	
S.	81°		N.	30.	77	"	
N.	76°		N.	15.	00	"	
N.	3 1/2°		N.	21.	87	"	
N.	16 1/2°		N.	8.	89	"	Set post for 1 mile
N.	19 1/2°		N.	9.	00	"	
N.	9°		N.	4.	70	"	
N.	19 1/2°		E.	7.	83	"	
N.	35°		N.	6.	20	"	
N.	27°		N.	21.	00	"	
N.	13 1/2°		N.	4.	80	"	
N.	31°		N.	5.	00	"	
N.	27 1/2°		N.	7.	50	"	
N.	67 3/4°		N.	4.	62	"	
N.	14 1/2°		N.	3.	27	"	
N.	8 1/2°		N.	2.	89	"	
N.	13°		E.	6.	00	"	
N.	11°		N.	6.	09	"	Set post for 2 mile
N.	31°		N.	7.	00	"	
N.	61 1/2°		N.	8.	00	"	
S.	82 1/4°		N.	4.	50	"	
N.	67 1/2°		N.	6.	46	"	To Center of section 33 at 54.00 Set 3. mile post
N.	80°					"	Center of Section 32
							at 26.00
							4 miles
							5 "
							106.00
							160.00 to the 1/4 Section 20, 21, 3, N. 32, E.

62-1-A

mash		at 16.00	Set 6 mile post
"		40.00	to Cor for Sec 17, 18, 19, + 20. S. 3. N. 32. E.
N. 60° W.		40.00	1/4 Cor Mash Band of Sec 17.
N. 68 1/2° W.	80.00	16.00	Set 8 mile post
N. 77° W.	27.50		
N. 71° W.	40.00		
N. 6 1/2° W.	40.00	12.50	9 mile post
N. 62 1/2° W.	23.50		
N. 75 1/2° W.	29.00		Set 10 " "
N. 64 1/2° W.	66.75		
N. 39° W.	13.25		" " 11 " "
N. 14 1/2° W.	55.30		
N. 36° W.	24.70		" " 12 " "
N. 62° W.	52.50		
N. 47 1/2° W.	27.50		" " 13 " "
N. 28 3/4° W.	11.00		
N. 62 1/2° W.	18.25		
N. 57° W.	55.50.	58.75.	" " 14 " "
N. 72° W.	53.25		
N. 51° W.	22.00		" " 15 " "
N. 61 3/4° W.	18.75		
N. 67 1/2° W.	26.50		
S. 82 1/10° W.	22.25		
S. 89° W.	12.50		" " 16 " "
N. 60° W.	22.50		
N. 71° W.	57.50		" " 17 " "
N. 6 1/2° W.	119.00, 80.00		" " 18 " "
N. 7.7 1/2° W.	8.00		leave Deepain Creek
N. 67 1/2° W.	3.50		
N. 25° E.	29.50		19 mile Post
N. 17° E.	80.00		20 " "
N. 2° W.	37.50		
N. 16 1/2° W.	18.00		
N. 26° E.	5.50		
N. 1° E.	65.00	19.00	21 " " back Thomas + Ruelle Road
N. 6 1/2° W.	8.50		
N. 35° W.	14.50		
N. 44° W.	75.00, 11.00		22 " "

Rd #1-A

N. 8 1/2	N.	16.00	23 mile Post
N. 5°	N.	7.80	
S. 79°	N.	3.16	
N. 59 1/2	N.	10.28	
N. 47°	N.	21.66	
N. 8°	N.	12.00	
S. 79°	N.	10.00	
N. 40.	N.	18.50	at 15.10 chs Set 24 mile post
N. 44°	N.	172.68	..76.60 .. 25
			..156.80 .. 26
S. 63°	N.	9.34	
N. 63 1/2	N.	7.50	
N. 43 1/2	N.	5.00	
N. 47 1/2	N.	16.50	
N. 30 1/2	N.	5.00	
N. 52°	N.	4.00	
N. 83°	N.	4.00	
S. 87°	N.	5.50	
N.		10.50	at 7.28. 27
N. 22°	N.	36.35	
S. 68	N.	7.50	

Total distance 27 miles 44° 15 chs

4m 1/2

"































Rd #1


5'

4'

3'

2'

Rd #1-A

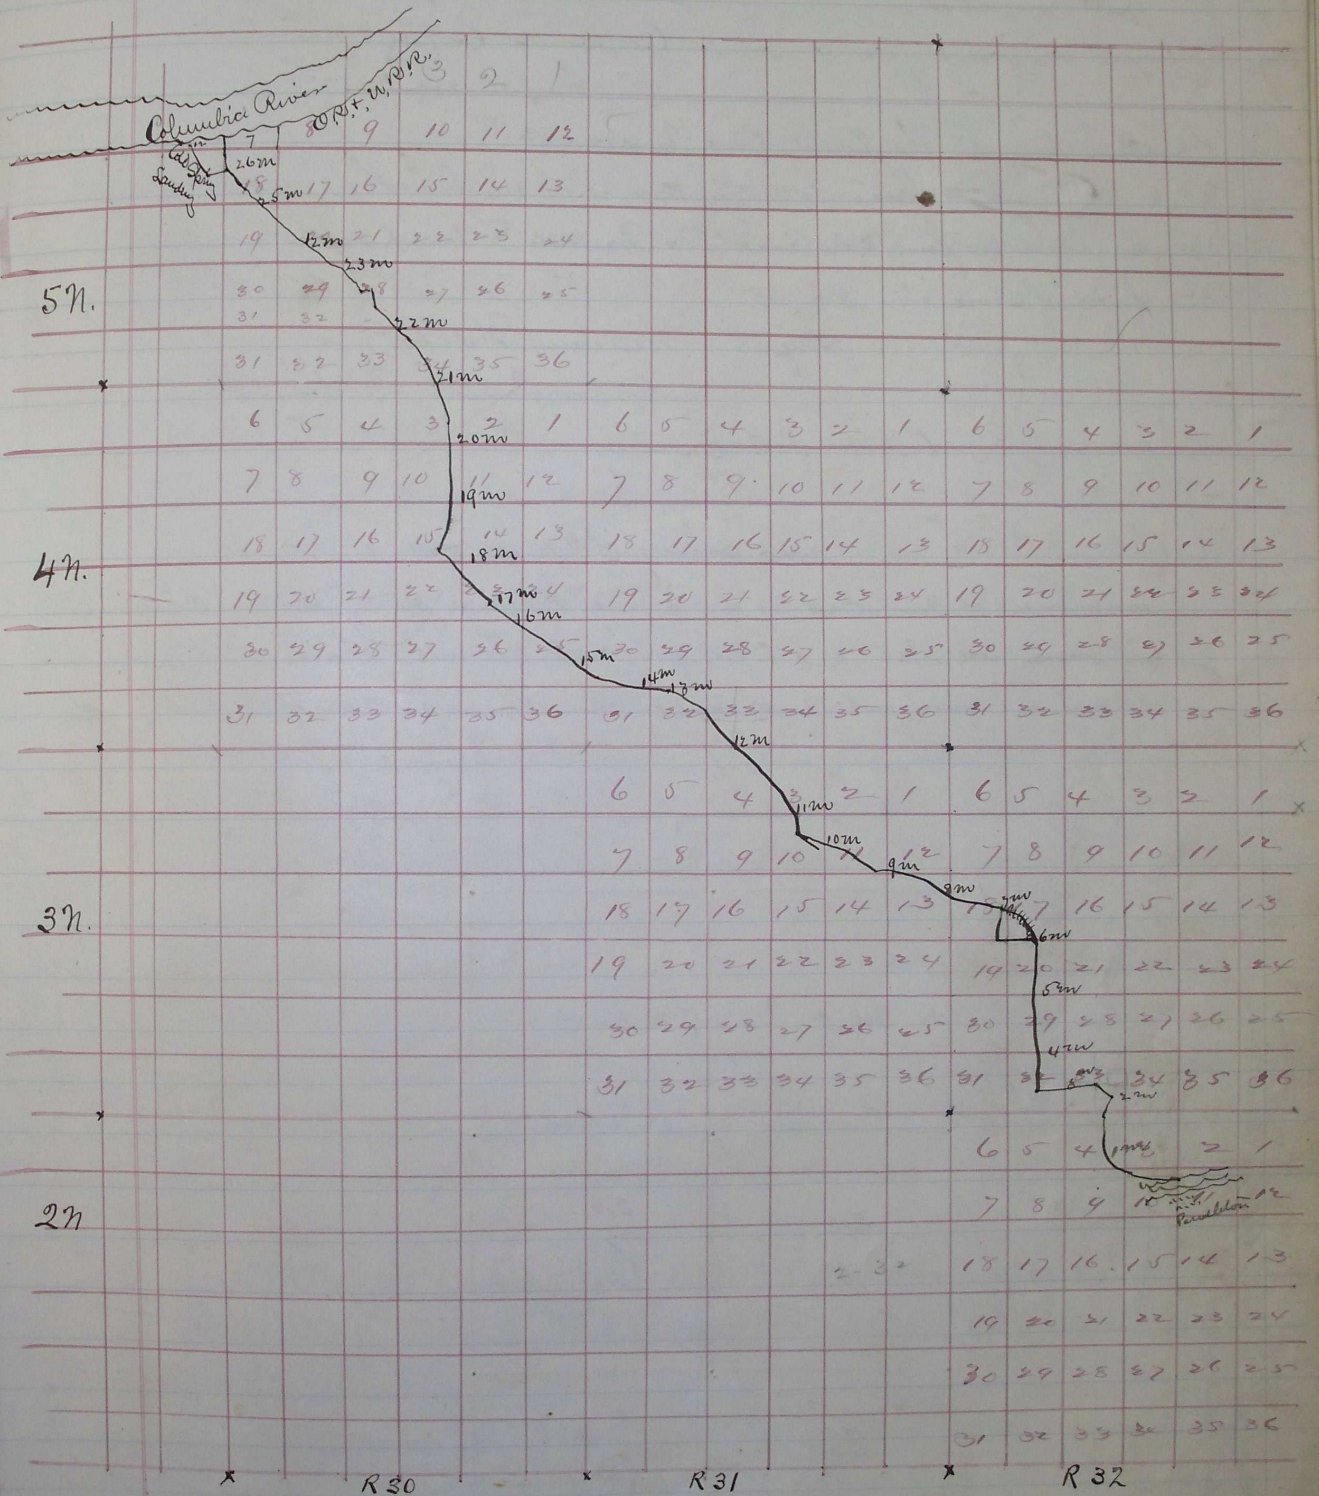

located & granted at April term 1880.

Filed April 15th 1880

J.B. Kenny cert

Journal 10, 5-80