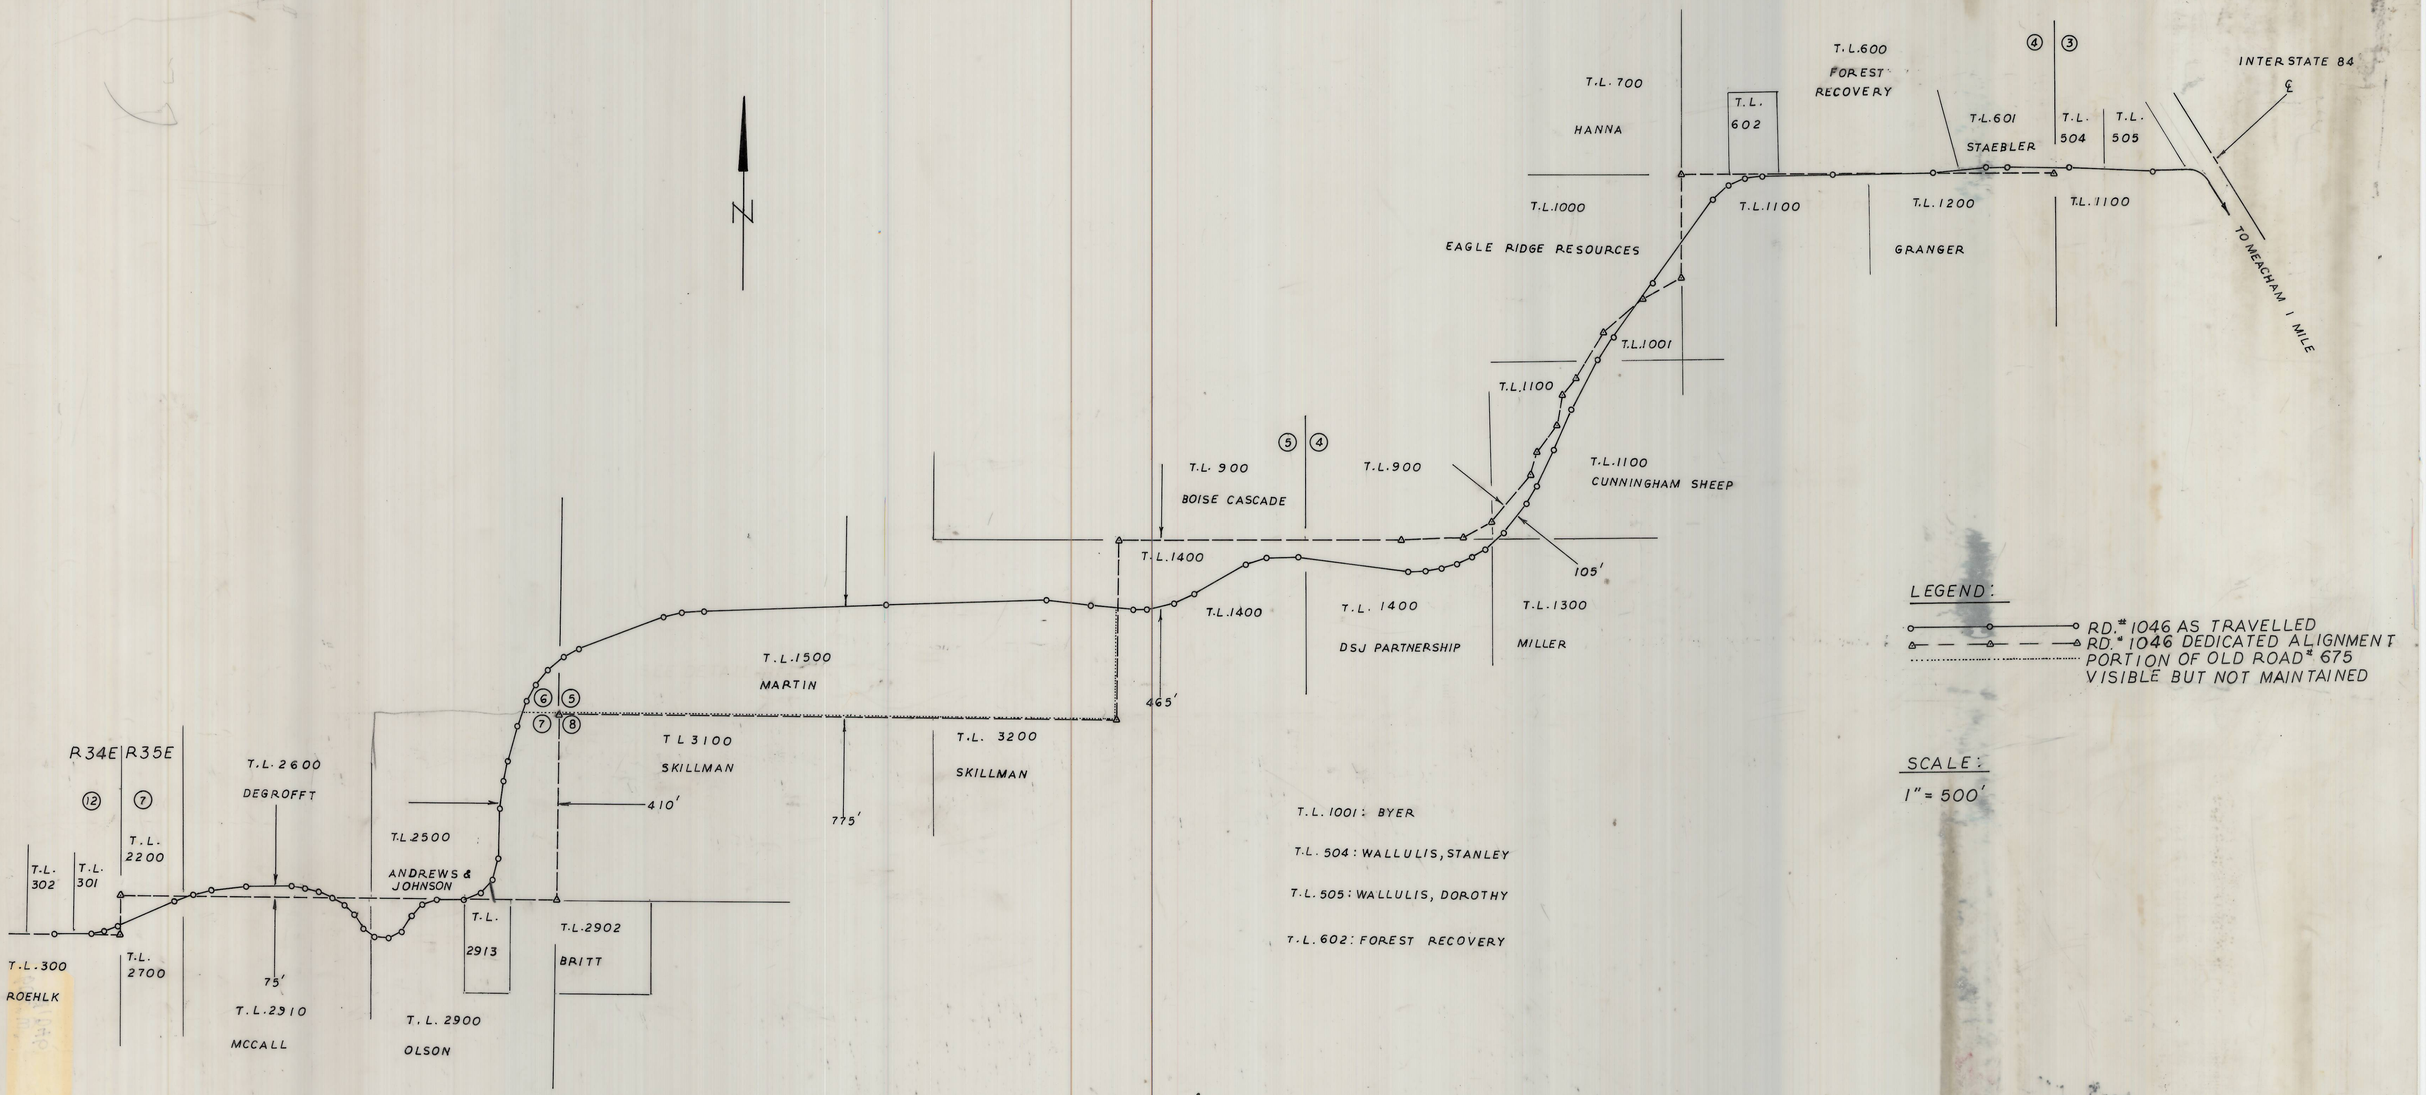

LEGEND:

RD.# 1046 AS TRAVELLED
RD.# 1046 DEDICATED ALIGNMENT
PORTION OF OLD ROAD# 675 VISIBLE BUT NOT MAINTAINED

SCALE:
1" = 500'

T.L. 1001: BYER

T.L. 504: WALLULIS, STANLEY

T.L. 505: WALLULIS, DOROTHY

T.L. 602: FOREST RECOVERY

T.L. 301: CASTNER, SHOEMAKER, MARTIN, CHOWNING

T.L. 302: PERSONETTE

T.L. 2200: CASTEEL

T.L. 2700: GORDON

T.L. 2913: BELLINGER

MAP OF SURVEY FOR VACATION OF A PORTION OF COUNTY ROAD# 1046 (ROSS ROAD)

SURVEYED BY GARY ROBERTS, PLS

SURVEYED FOR UMATILLA COUNTY ROAD DEPARTMENT

LOCATED IN TOWNSHIP 1 SOUTH, RANGES 34 AND 35 EAST

NOVEMBER, 1994

"W" BOX