


Range

35

E W N

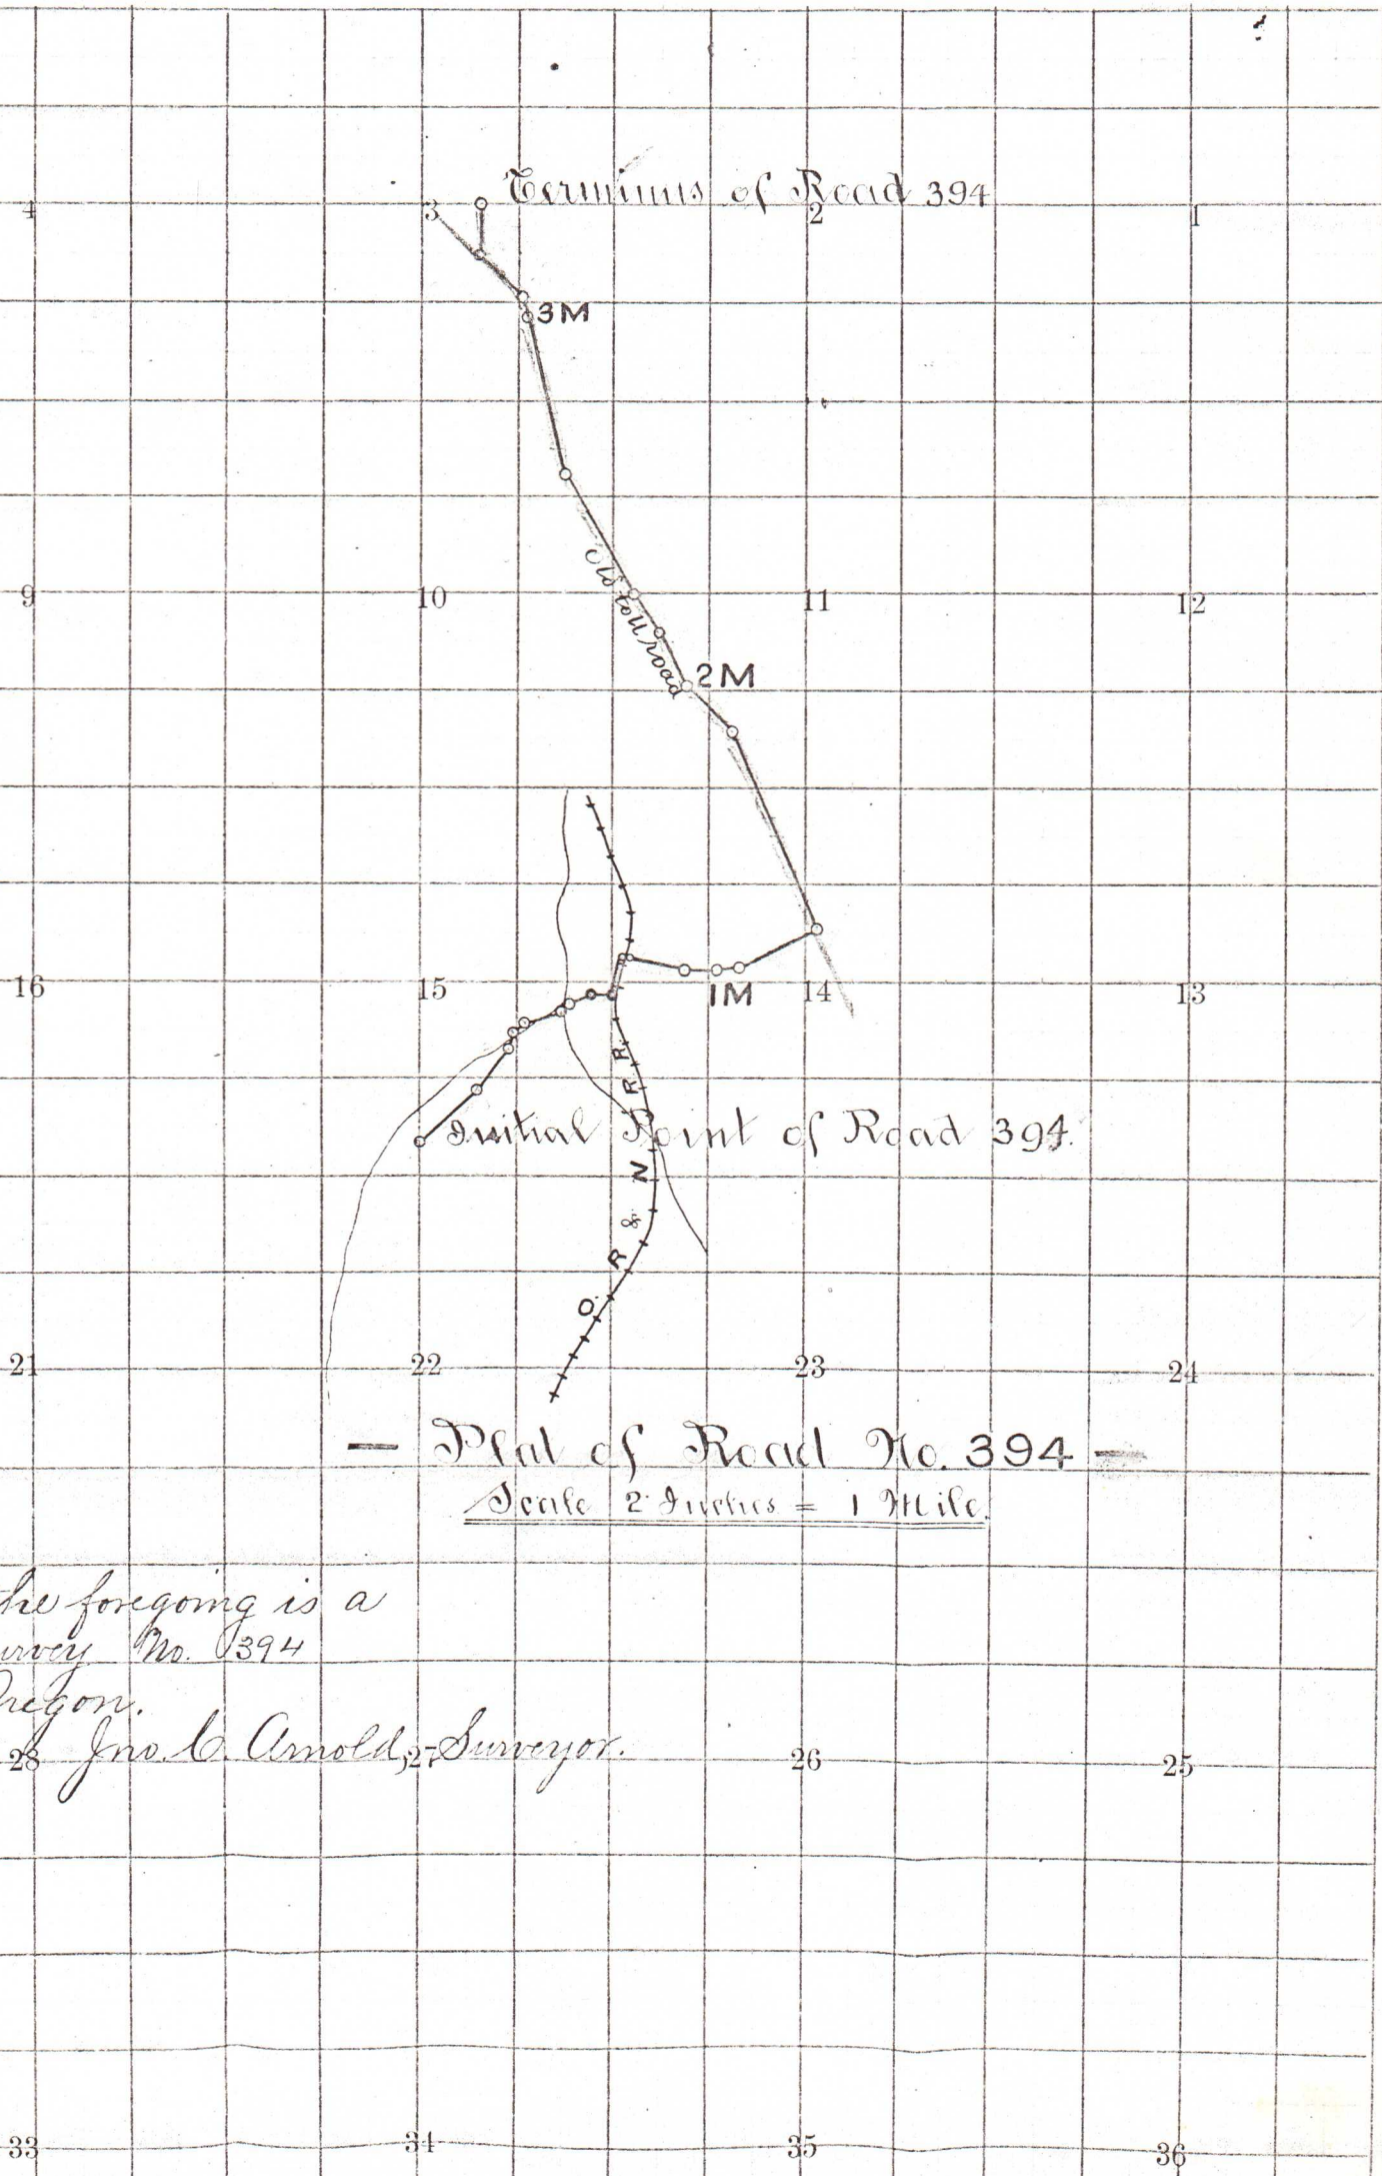

That the foregoing is a
 road Survey No. 394
 in the County of Oregon.

28 Jno. G. Arnold, 27 Surveyor.