

ROAD No  
418

In the Matter of Viewing, Surveying and laying out County Road No. 418

Com at a point where the Pendleton and Canyon City Road crosses the section line between Sec's 9 & 16 in Township 1 South of Range 32 E. from, thence running due East as nearly as practicable along the section line between sections 9 & 16, 10 & 15, 11 & 14, 12 & 13 to the NE corner of SW 1/4 Sec 12. thence due north as nearly as practicable to the NE Cor of SW 1/4 Sec 1. thence due East on section line between sections 1 & 12. same Township and Range to the west line of the New Reserve.

Viewers Report.

To the Honorable County Court of the State of Oregon for Umatilla County.

We, the undersigned, the Viewers heretofore appointed to and locate Road No 418. submit the following Report. Pursuant to an order to the Honorable Court we met Jno. C. Arnold, County Surveyor, at Pilot Rock, Oregon on April 24<sup>th</sup> AD. 1893, and were by him, duly sworn to faithfully and impartially discharge the duties of our appointment. We called to our aid Edgar Thomson, George Rugg, Chairman, markers, who were by the Surveyor elect, duly sworn. We viewed, surveyed and located said Road No 418 as specified in our order. We find the Route practicable, and the Road appears to be very much needed. We would therefore recommend that said Road Numbered 418 be declared a Public Highway, said Road to be 60 ft wide.

Witness our Respective hands as below.

Herbert Boylen }  
G. W. Rugg } Viewers of Road Survey No 418.  
A. Waugh }  
Filed May 2<sup>nd</sup> 1893 }  
Wm Pierce, Clerk }

the  
of William  
Oregon

Field Notes of Road Survey No 418 for Umatilla County Oregon  
I met H. Boylen, Geo Rugg, and A Waugh, viewers  
on Road 418 at Pilot Rock, Oregon, April 24<sup>th</sup> AD. 1893

at 10 AM We call Edgar Thomson and Geo Rugg to chain  
and mark. Each duly qualify, after which, under  
directions of said Viewers, I set initial post at  
point of Intersection of the Pendleton & Canon City  
wagon Road, with the line bet Sec's 9 & 16 in Tp 1  
SR 32 Eum and run thence, on said Sec line  
ascend gently,

East

North

East

East

- 400' Ravine. Course, NW. Ascend steep pitch  
500' Summit of steep Ascend, thence Ascend gently.  
1000' Main Summit  
1400' the  $\frac{1}{4}$  Sec Cor Stone bet Secs. 9, 16.  
1700' Away, Course NW Ascend over Ridge  
2660 Ravine. Course, NW. ascent steep pitch.  
2800 Summit.  
4067 Probable Cor to Sec's 9, 10, 15, 16  
4890 Ravine. Course NW. Ascend.  
5280 Set 1 m. P. 30' N. of line.  
Continue on line between Sec's 10 & 15  
500 Summit  
1500 Descend.  
2900 Ray Creek. course N. - Ascend.  
3300 Summit  
3950 Fence on W. side of Mr S. Lane }  
4012 " " E. " " " " } Capt Martin place.  
4090 Stewart Creek 20' wide runs NW.  
4150 Ascend Hill.  
4642 Stone mound on W. hill side  
5000 Summit,  
5280 Set 2. m. P. 30' N. of line.  
Continue on line bet Sec's 11 & 14  
1859 Probable  $\frac{1}{4}$  Sec cor. bet Sec's. 11 & 14  
2600 Descend.  
3700 Foot of hill. Harrison's house. bears N. about 250 ft  
3890 Little McKay Creek 20' wide. course N.  
3920 Ascend hill.  
4050 Cor to Sec's 11, 12, 13, 14  
4500 Summit  
5280 Set 3. m. P. 30' N of line  
Continue on line bet Sec's 12 & 13.  
320 Ravine. Course N.W.

by Oregon  
viewers  
1893  
to chain  
under  
at  
City  
Sp 1

- East 1294' The 1/4 Sec cor. bet Sec's 12 & 13. Set. a. p. mkd. ↑  
at cor fences. S & E, and turn thence through centre Sec 12
- North 3600 Ramboe House, about on line,  
continue on line through Centre Sec 12. N & S.
- 1270 The 1/4 Sec cor. Stone bet Sec's 1 & 12. Set a. p. mkd. 2.  
and turn thence along line bet Sec's 1 & 12
- East 1360 Cabin bears S. of line 60' dist
- 1660 Ravine. Course. N. Ascend.
- 2000 Summit
- 2300 Decend.
- 2610 Spring Branch 10 ft wide cours. N. ascend.
- 2950 Summit
- 3932 Stone mkd. DR on E. face. Cor fences  
Set terminus on knoll 45 ft S of said Stone

All this parts are of proper size and are marked  
and set in mounds according to law for the same.

I hereby certify that the foregoing field notes  
for Road Survey No. 418 for Umatilla County  
Oregon. are correct.

Jno. C. Arnold County Surveyor.


Filed May 3<sup>rd</sup> 1893 }  
Wm Pierce }  
Clerk }

### Plat of Road No 418

I hereby certify that the foregoing is a correct plat of Road Survey No 418. for Umatilla County Oregon.

Jno. O. Arnold. Surveyor.

Township 1 S Range 32 E Wm

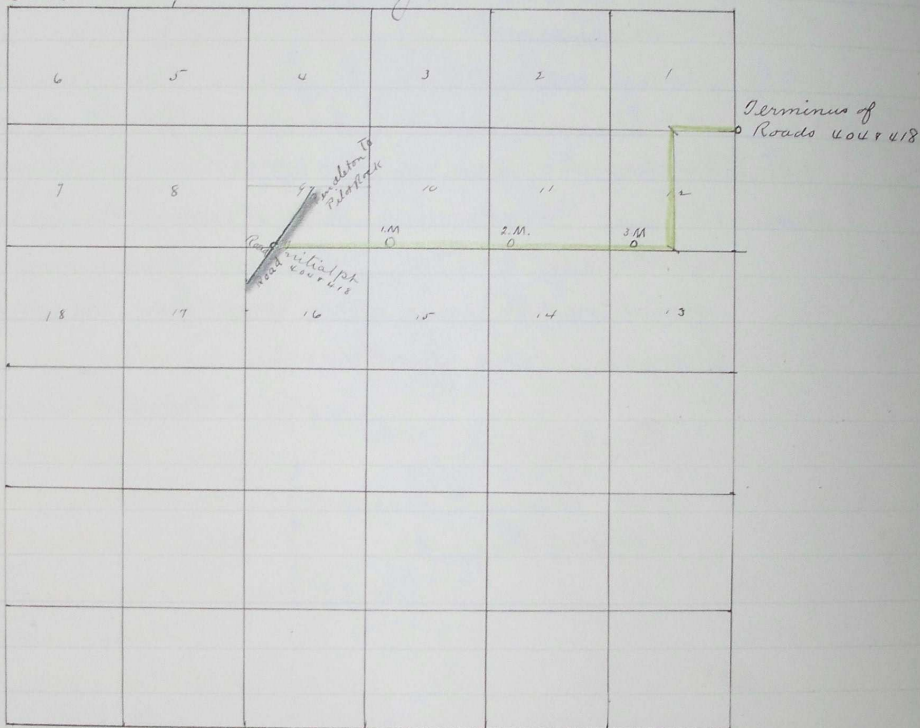

Filed May 3<sup>rd</sup> 1893 }  
 Wm Pierce. }  
 Clerk }

1480