


PLAT OF COUNTY ROAD No. 741
INT. 1 N. R. 32 E., W. M.

SURVEYED AUG. 23 1912.
Scale 25 Chs. = 1 In.

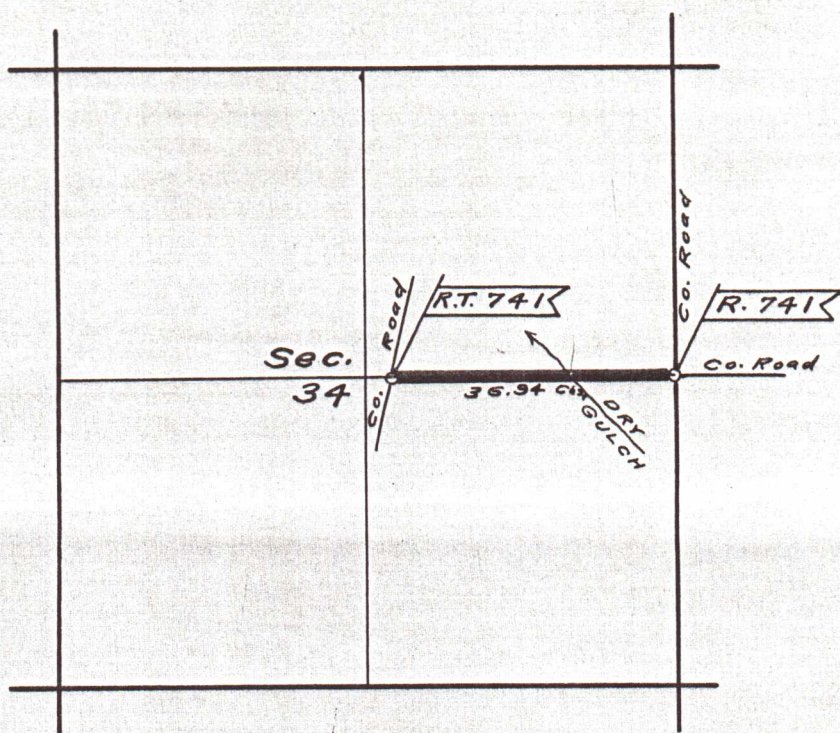

Geary Kimbrell
County Surveyor