

## Road No 179.

ROAD NO  
179.

Report of Viewers. Field Notes and Plat of Survey of County Road beginning at a point on the Co Road known as the Stage Road leading from Pendleton via Prospect to Umatilla. to the intersection of Co Road leading from Pendleton to Cold Spring Landing.

## Report of Viewers.

We proceeded to view and survey said Road as set forth in the order. we find the proposed road a good practicable route and very much needed. we would ask that the petition for said road be granted.

This the 13<sup>th</sup> day of March 1884.

S. M. Driver }  
John Myers } Viewers  
J. Hardwick }

## Field Notes of Road No 179.


Commencing at a point on the County Road known as the Stage Road leading from Pendleton via Prospect to Umatilla. at the  $\frac{1}{2}$  mile post between Sec 31 & 32 T<sup>3</sup> N. R 32 E. set post marked R. run North on line 3.20 Rods. set post miles one. run North on line between Secs 19 & 20. 3.20 R. set post miles two. Run North on line between 17 & 18) 3.20 Rods set post miles three. Run North on same line 44 Rods to Despain Canyon. Angle thence down said Despain Canyon. West 5 deg North 140 Rods. Angle thence West 40 North 64 Rods. Angle thence West 10 deg N. 86 Rods. Angle thence West 35 deg N. 10 Rods set Post marked 4 miles. Angle thence West 35 N. 80 Rods. Angle thence West 25 d N. 22 Rods. Angle thence West 20 S. N. 128 Rods. Angle West 10 d. N. 90 R set post marked 5 miles. Angle West 10 d N. 20 Rods. Angle thence West 30 N 10 Rods. Angle thence West 20 deg North 140 rods to intersection of County Road in Despain Canyon. near the center of Sec 11. T<sup>3</sup> N. R 31 E. set Post marked R.

Surveyed March 13<sup>th</sup> 1884

W. W. Caviness  
Surveyor

Plat of Road No 179. on page 412.

Plat of Road N<sup>o</sup> 179.

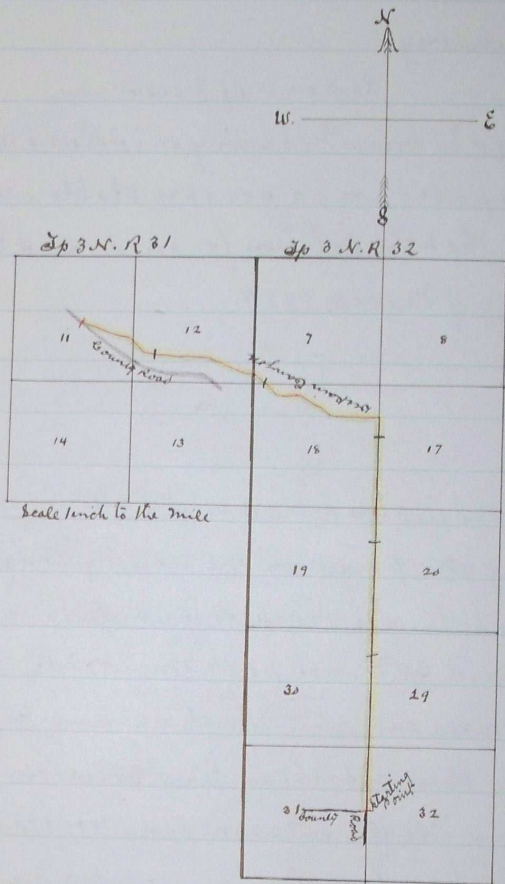

I hereby certify That this is a true Plat of Road Survey  
of Road N<sup>o</sup> 179.

Surveyed March 13<sup>th</sup> 1884

W. W. Caviness

Surveyor

Journal F. page 256

" F. " 318

Recorded May 10<sup>th</sup> 1884

J. P. Bushie

Clerk.