Roport of Viewers. Field Notes us Plat of Survey of a County Road beginning at the School House in See 10 Sp 3ck. R 31. to the intersection of the Co Road leading from Pendlelan to Umatilla via Prospect.

Report of Viewer We proceeded to view and survey said roas as set forth in the order, we find the route to here mentioned to be a good practable Road and much needed and can be opened with but little expense to the bounty, we would ask that the petition be granted

This the 11" day of March 1884.

S. M. Driver }

John Myers }

Viewers


J. Hardwick }

Field Noles of Road Survey Nº 182, Commenced at School House on Sec line between Secs 104114 3 N. R 318 EtPostmarked R.

Run & outh on line between See's 10411. 320 Rods set Post marked one Mile. South on See's line between See's 14415 2.60 Rods. Angle thenel. East bo Rods on line between See 14423 set Post marked livo miles, Run East 3.20 Rods set Post on line between See's (13424) marked three miles. Run East 320 rods set post marked 4 miles, on line between See's 18419 in Sp3 N. R 32E. Run East on line to the b. E. corner of See 18 same If & Range 2.80 Rods. Angle thence bouth on line between Sec 19420. HO Rods eet Post m-5 miles. Run South on line 3.20 Rods Set post M. 6 miles Run South on line 3.20 Rods Set post M. 6 miles between be come between Sec 19420.

Surveyed march 11"/884

W. W. Caviness Surveyor

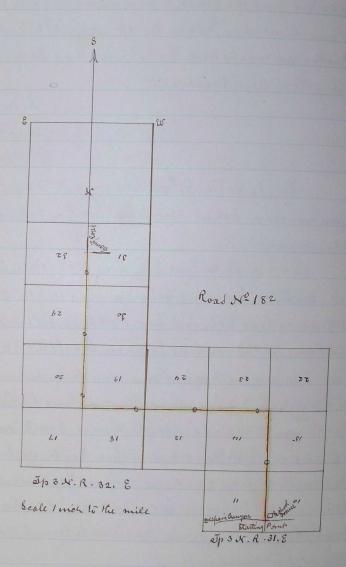

I hereby certify that this is a true Plat of Road Survey Nº 182 this the 11th day of march 1884

W. W. Caviness Surveyor

Journal F. page 257
" F. .. 317
Recorded May 10" 1884
JPBushee

Clerk.