

Report of Viewers. Field notes and plat of survey of a
County Road from line between Sec's 30 & 31 T3 NR 30 E. to the
N cor Sec 33. T3 NR 31 E. Road No 149

To the Hon. County Court for Umatilla County Oregon

We the undersigned having been appointed by your Hon. body
to view out and survey a County Road in the above named County
and State, would respectfully report that we met at the time and place
appointed, and after being qualified by A L Coffey County Surveyor
we called to our aid Ira Buzaw and C R Henderson as chairman
and Ira Buzaw as marker, we proceeded to view out and survey
said road commencing at the N corner of Sec 33 T3 NR 31 E. by
planting a post marked R, which we run north on said sec line
one mile. then west on the section line, to the East boundary of T3
NR 29 E. thence S.W. down a ravine to the intersection of the U. S.
M. R on Umatilla River, we find the road a good practical
road and much needed and easily opened and kept in repair
We would therefore ask that the prayer of the petitioners be granted

This 27th day of April 1883

E Lobenstein

C R Henderson

James M Elgin

Field Notes.

Survey and plat of road commencing at the S.W. corner of Sec
33. T3 NR 31 E by planting a post marked R. from which we
run North.

North 80.00 set post 1 mile and angle thence west on Sec's lines

West 80.00 " " Marked 2 M

" 80.00 " " " 3 "

" 80.00 " " " 4 "

" 80.00 " " " 5 "

" 80.00 " " " 6 "

" 80.00 " " " 7 "

" 80.00 " " " 8 "


S 22° E 28.00 Angle then

S 22° E 32.00 Angle then

45° W 38.50 Angle then

West 69.50 Angle then

N. 45° W 75.00 angle then
 S 65° W 80.00 Set post marked 9 m
 S " " 13.00 Angle then
 S 25° W 31.00 " "
 S 43° W 38.50 " "
 S 69° W 69.00 Intersect U.S.M.R. and set post marked R

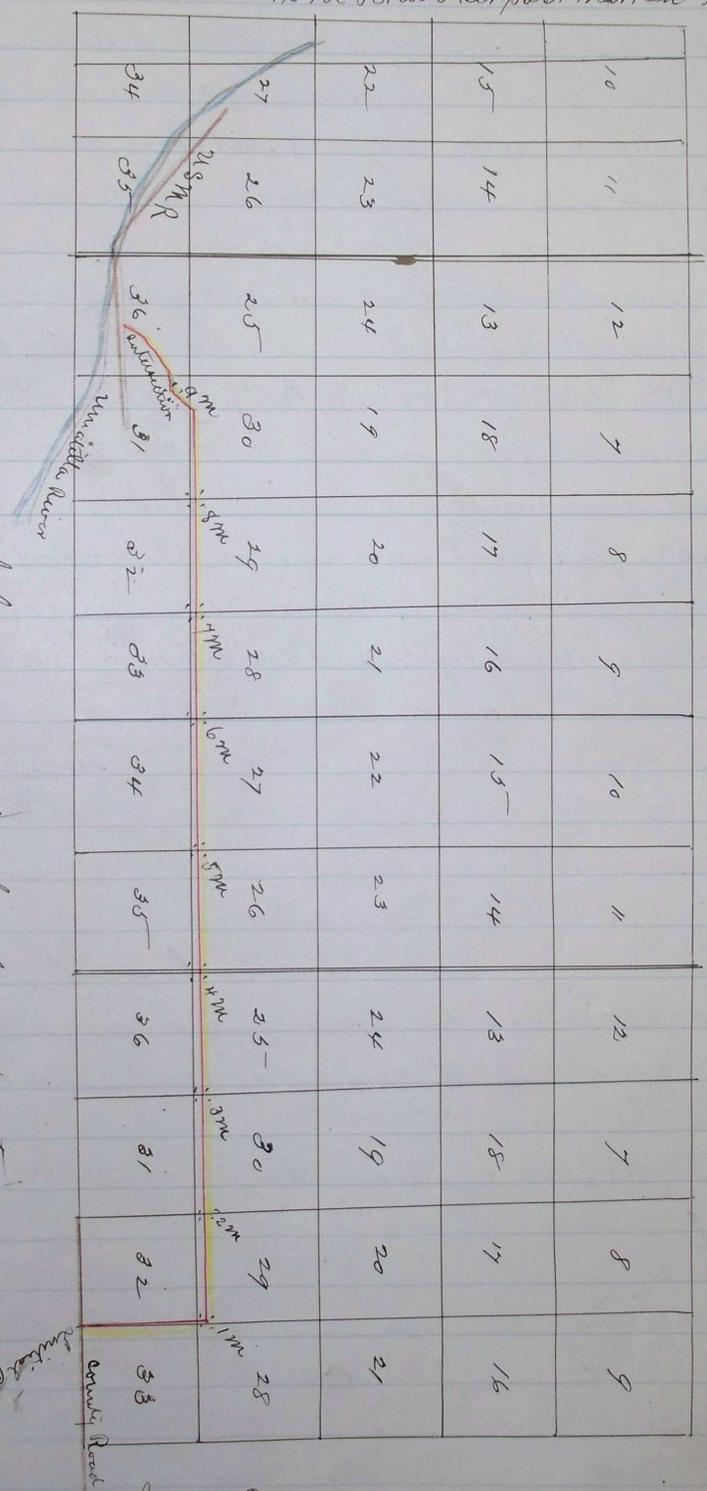

The above is a true and correct plat of Road No 149.

O.S. Coffey
 County Surveyor of Umatilla County Oregon
 April 28th 1883

Low Co. page 739

Recorded August 2 1883.

J.P. Bushe Clerk