

473

IN THE COUNTY COURT OF THE STATE OF OREGON FOR UMATILLA COUNTY

In the Matter of the Approval of Report
of Viewers on road to be Vacated Beg at
Sec cor common to secs 11, 12, 13 & 14

T 3 N R 30 E W M

Now on this day this matter coming on for consideration upon the report of the board of county road viewers heretofore instructed at the July 1910 term of this court to view and report upon petition to vacate county road, petitioned for by H R Lorenzen et al, as follows: All that part of the county road and public highway commencing at the Sec cor common to Secs 11, 12, 13 and 14 T 3 N R 30 E W M, thence east along the sec line between said secs 12 and 13 to the twp line at SE cor Sec 12 in Said twp and range, thence between the SW 1-4 of Sec 7 and the NW 1-4 of Sec 18 T 3 N R 31 E W M and terminating at the cor common to the SW 1-4 and SE 1-4 of Sec 7 and the NW 1-4 and NE 1-4 of Sec 18 T 3 N R 31 E W M.


And it appearing to the court that said board of viewers has reported favorably and recommended that said petition be granted and said road be vacated, and the plat and field notes being on file and certified to by the surveyor appointed to survey the same, and the court being satisfied that said road is no longer necessary as a county road,

It is hereby ordered that said report be accepted and approved, the plat and field notes duly recorded, and the said road be and the same is hereby vacated as a county road and the road master instructed to close the same.

Plat of Portion of Road No. 165 To be vacated

T. 3. R. 30. E. W. N.

T. 3. N. R. 31. E. W. N.

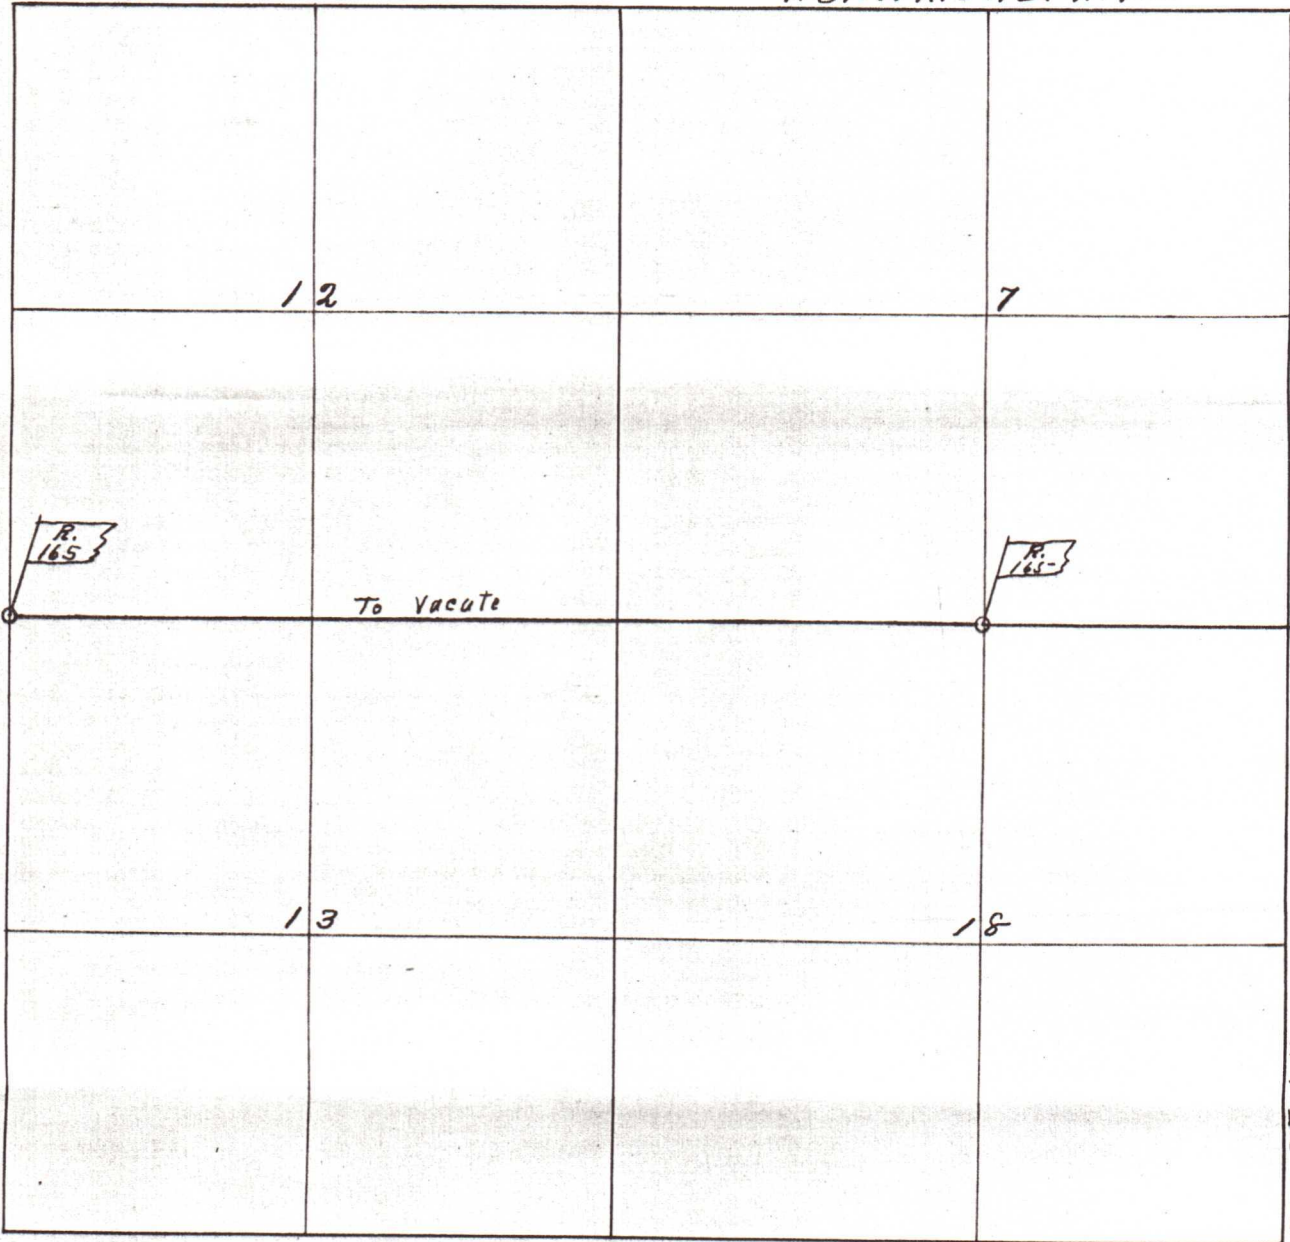

Field note of a portion of Road No. 15 -
to be vacated

Commencing at the corner common to sections
11-12-13 and 14 in T3N16308W1M
thence East between sec 12 & 13 T3N16308
and sec 7 & 18 T3N16318W1M 122.50 chains
to the 1/4 section corner common to
sec 7 & 18 T3N16318W1M intersecting
County Road running North and South through
center of sections 7 and 18.

I hereby certify that the foregoing field
notes are correct as surveyed by me
on the 19th day of July 1910

John W. Kimbrell County Surveyor
for Washtilla County Oregon