

ROAD NO
288

Road N^o 288

Report of Viewers. Field Notes^{2d} Plat of Survey of Co Road Comenz at Sr. E. cor Sec 14 T³ P³ N. R 30 E. W. M. ^{2d} ending at Co Road leading from John Morlons to Pendleton.

Report of Viewers.

May 2^d 1887

We the undersigned, viewers on road N^o 288, petitioned for by Geo Reese et al, would report that we met the County Surveyor at time^{2d} place appointed, ^{2d} proceeded to view out^{2d} surveyed said road as petitioned for, we find the road located on excellent ground, ^{2d} all opened ^{2d} traveled excepting one 1/2 miles, the road will be very easy kept in repair ^{2d} is very much needed by the public; we would therefore recommend that the prayer of the petitioners be granted & said road be declared a public highway.

J. F. Temple }
George Peebler }

Field Notes of Road Survey N^o 288.

Met viewers, Geo Peebler ^{2d} Jno. Temple at residence of Geo. Reese May 2nd 1887, ^{2d} calling Geo Reese ^{2d} J. S. Sanders to act as chain bearers ^{2d} Elias Hevel as marker, after duly qualifying each party, I commence at corner for Secs 11, 12, 13 & 14 T³ P³ N. R 30 E ^{2d} run thence, on line bet Secs 13 &


	14.		Var 20° E.
Course	Feet		
South	2650	1/4 Sec. cor bet. Secs 13 & 14 - Cut A on post in angle of joining N & W, about 30 ft. N. W. of point, near residence of Geo Reese.	
		Thence through center. Section 14.	
West	5270	wire fence N & S.	
"	5280	Set 1 M post about 15 ft. N. of line - Continue course. Through center Secs. 14 & 15	
"	5280	Set 11 M post about 30 ft. south of line.	
"	2665	1/4 Sec. Cor. bet. Secs 15 & 16 - Cut A on fence post on East side of lane, ^{2d} turn thence along road in lane ^{2d} on line bet. Secs 15 & 16	
South	5280	Set 111 M post about 20 ft. west of line. Continue on line bet. Secs. 21 & 22	
"	5280	Set 15 M post in lane about 20 ft. East of line, at residence of L. D. Spears, continue on line bet. Secs 27 & 28	
"	5340	Intersect road from Echo to Pendleton Course E & W set Mercurius marked R on N.	

I hereby certify the foregoing to be a correct copy of the field notes of Road Survey N^o 288.

Jno C. Arnold. Surv. Unadilla Co. O.

Plat of County Road No. 288
Umatilla Co., Oregon

Township No. 3 N. Range 30 E. W. M.

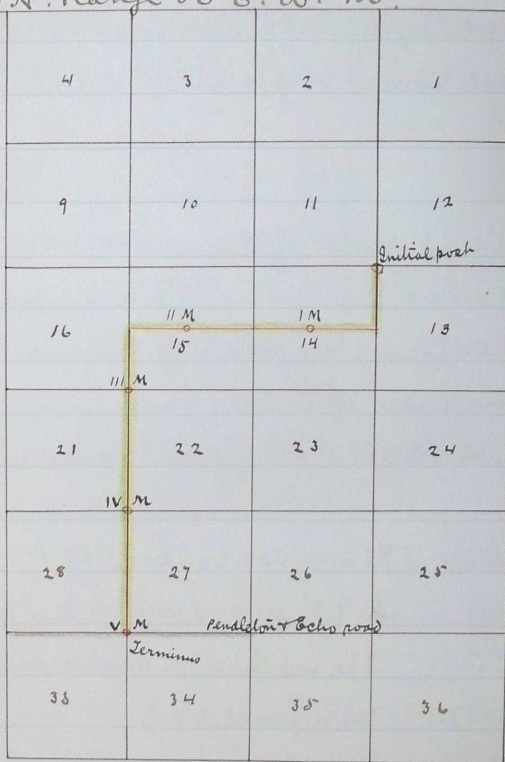

Journal G, page 525

" G " 587

Recorded Aug 5th 1887

G. A. Hartman

Clerk

By J. H. Parkes, Deputy.

I hereby certify the foregoing to
be a correct plat of the survey of
Road No. 288.

Jno C. Arnold, Co. Surv.

Vault Box No. 279