

ROAD NO

300.

"Road No 300."

Report of viewers field notes and plat of survey of County Road No 300 in Umatilla County Oregon, commencing at the center of or quarter post on the East boundary line of Section Fifteen 15th in Township Three North Range Thirty One East of the Willamette Meridian the same being a point on County Road No 182 being the road running from the school house in Section 16 Twp NR 31st to intersection of County Road running from Pendleton to Umatilla via Prospect, and running from said point due West through the center of Section Fifteen 15th Township Three North Range Thirty One 31st East one mile, to the center of the East boundary line of Section Sixteen 16th same Township and Range, thence North on said line between said Sections Fifteen 15th and Sixteen 16th Eighty 80 rods, thence West across said Section Sixteen 16th and distant Eighty 80 rods from its Northern boundary one mile to the line between Sections Sixteen 16th and Seventeen 17th, thence South on said line between said Sections Sixteen 16th and Seventeen 17th Eighty Rods to the center of or quarter post on said line, thence due West through the center of Section Seventeen 17th and eighteen 18th Township three 3rd North of Range Thirty One 31st East and the center of Section Thirteen 13th Township Three 3rd North of Range Thirty One 31st East three miles to the quarter post on the Section line between said Section Thirteen 13th and Fourteen 14th same Township & Range, thence South on the Section line in Township and Range between said Sections Fourteen 14th and Thirteen 13th one half mile, between Sections Twenty Three 23rd and Twenty four 24th same Township and Range one mile, between Sections Twenty five 25th and Twenty six 26th same Township and Range one mile, between Sections Thirty five 35th and Thirty six 36th same Township and Range three quarters of a mile to a point on said Section line between said Sections Thirty five 35th and Thirty six 36th eighty rods North of the South West corner of said Section Thirty five 35th thence South

Westerly, diagonally across said Section Thirty-five 35th and across Section Two 2nd in Township Two 2nd North of Range Thirty 30th East by the most-practicable route to what is known as the Baker Bridge across the Umatilla River

"Report of Viewers"

To the Hon County Court
for Umatilla County, Oregon

We the undersigned viewers would on County Road No 300 for Umatilla County Oregon would respectfully Report that we met with Jno C Arnold County Surveyor at the time and place appointed by your Hon Body and proceeded to view out and survey said Road 300 We find the road located upon Section and Sectional subdivision lines and upon comparatively good ground, the road will be comparatively easy to open and keep in repair The road is much needed and we believe the grade north of Umatilla River to Bakers bridge on said river to be the best and most practical that can be found

We therefore recommend that said road be declared a Public highway

Filed Sept 6th 1881
Is A. Harrington

J. T. Temple {
George Gibson ^{Viewers.}

"Field Notes"

of the Survey of County Road No 300 Umatilla Co Or

I met John T. Temple and Geo Gibson viewers on road survey No 300 for Umatilla Co Or at the beginning of said road Monday Aug 29th 1881 A.R. Simpson and D. Bowdysheil were called to act as chain and Jno T. Temple as marker each of whom aforesaid. I qualified as required by law

I set initial post in mound 30 North and 30 West of the 1/4 S cor. bet Dees 14 + 15 & 3 NW 31 E and run thence on true center through Dee 15

Deseed

West 310 ft Ravine Dee. - 16; ascend

600. Summit

700. Deseed

Thirty-
ous help
og the
m as
River

or world
country
we met
the time
and
load 300
and
our
e com-
repair
The
is bridge
sticel

s ba

on
Viewers.

ella too Or.
viewers
Or at
s 29"1887
need to
ster
o requi-

orth and
NR 31E
in Dees 15

	1150 ft	Ravine et.W. - 6; ascend
	1400.	Summit
	1510.	Ravine et.E. - 4 ascend abruptly
	1560.	Summit of steep ascent; ascend gently
	2650.	Summit
	3400.	Descent gently
	3500.	Draa N.; ascend
	3850.	Summit
	5280.	Set 1 m post 30° N of line
North	30.	Cut A on 1 m post and turn on tree line bet Sec 15 & 16
	1300.	Descending to ravine et.W. angle in fence N.S. and W. Cut A on cor fence post and turn on tree quarter section line through N½ of Sec 16; ascend
West	1650.	Summit.
	2550.	Ravine N 4'
	3875.	" " - 5' ascend
	5280.	Set 2 m post 30° South of line in plowed field
	300.	Summit
	1333.	Buttered bet Dees 16 & 17; cor fencing N.S. and East Cut A on cor post in fencing and turn on tree line bet Dees 16 & 17
South	2700.	1/2 S cor. bet Dees 16 & 17; cut A on cor. post in angle of fencing N.S. E.W. and turn on tree line through center Sec 17
West	3800.	Ravine SW - 4'
	4650.	Gulch in Stage Canon
West	4950.	Abrupt ascent.
	5280.	Set 3 m post 20° N of line on E hill side continue tree line through center Sec 17 & 18
	500.	Summit.
	900.	Descented abruptly
	1222.	Gulch et 15; ascend abruptly
	1700.	Summit.
	2721.	1/4 S cor bet Dees 17 & 18
	2842.	Ravine NE - 4'
	5280.	Set 4 m post 30° N of line in stubble field continue tree line through center Sec 18 in R 31E and Sec 13 in R 30E
"	74.	Road in lane N & S Center Sec 18
	480.	Ravine et - 3 ascend
	1000.	Summit descended

- 1700.. Ravine NW - 4
 1887.. $\frac{1}{4}$ D cor bet Dees 18 & 13 on R line bet Rgs 30 & 31 E
 3300.. Ravine SW - 8 ascend
 4200.. Summit
 5280.. Set 5 m post about 30' west of line
 continue on true line through center Dee 13
 R 30 E
 " 216.. Purporling center Dee 13 S 3 N R 30 E
 550.. Ravine NW - 15' ascend
 800.. Summit.
 1100.. Descend.
 1600.. Foot of Descent.
 1975.. Ascend
 1950.. Summit
 1885.. Center Dee 13 S 3 N R. 30 E. Cut A on cor post in
 fence cor D. & W. on W side of Mouth of lane
 W. Turn thence on true line bet Dees 13 & 11
South
 5000.. Bass Ted Rees; Descend
 5280.. Ravine NW $\frac{1}{4}$ D set 6 m post about 30' west
 of line on West side of Ravine; ascend on
 same line
 1000.. Summit
 1865.. Center lane N. & S. $\frac{1}{4}$ D cor bet Dees 23 & 24
 5280.. Set 7 m post against fence on W side of lane
 Descend Continue on See line bet Dees 23 & 24
 and 25 & 26
 1760.. Foot of Descent. Gulch E. & S.
 1866.. $\frac{1}{4}$ D cor bet Dees 25 & 26
 5280.. Set 8 m post against fence on W side of lane
 continue on See line bet Dees 25 & 26 and 35 & 36
South
 2238.. Do for Dees 25-26-35-36
 7600.. Old Lee Wagon Road runs west
 1838.. $\frac{1}{4}$ D cor bet Dees 35 & 36
 3834..Leave lane N. & S. but A on cor post in angle
 of fencing N. & S. on W side of lane Turn
 thence, Descend,
 S 60° 15' W 4308.. Set angle Stake at pt Turn 28° 45' left
 S 32° 35' W 4750.. " " " " " 60° 10' "
 S 27° 35' E 5280.. " 9 m post about 30' West of Pt
 1004.. Gross fence N. & S.
 1200.. Set angle Stake at pt Turn 47° right.
 Gulch SW, ascend
 S 19° 25' W 1374

Gross same fence N.E.S.
 1471.. Cut A on fence post 1' east of pt Turn 320 10 right
 85° 35' W 2450. Summit. Descend down Caton to Ilmatilla R
 7886.. Gulch N.- S
 7974. Set angle stake at pt Turn 51° 45' Right Descend
 77° 45' W 3371. " " " pt below Goodnights house
 Turn 79° 40' left
 S 32° 00' E 5710. Set 10 m post in stone mound also cut x m on large
 barrel stone 18 x 24 ins in stone mound
 1d.. Set angle stake 2' West of pt Turn 61° 10' Right
 S 39° 10' W 780. Gulch S.
 450. Intersect Road no 265 leading to Grahams Station
 517.. Set angle stake at pt Turn 68° 15' R
 N 72° 36' W 1013. " " " " 36° 15' L to Bakers
 571° 10' W 2800. bridge on Ilmatilla River but R on brace in
 N end of bridge to mark the terminus.


I hereby certify the foregoing to be a
 correct copy of the field notes of Road Survey
 etc 300 for Ilmatilla County Oregon.

Jno C Arnold
Surveyor

Filed Sept 6-1887 }
G. A. Hartman }
Clerk }

ROAD NO
346.

Plat of County Road No 300.m

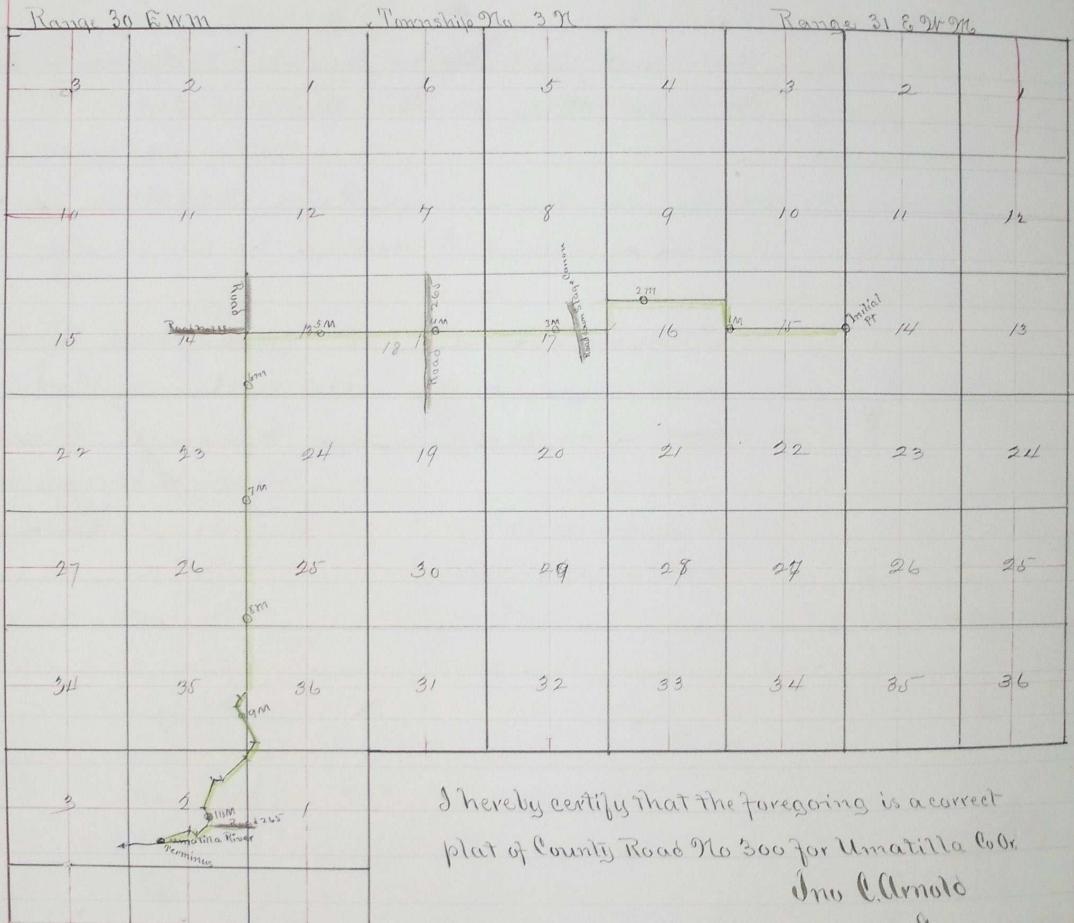

Filed Sept 1887
J. H. Hartman
Werk

Sep 8 1890 A 596