


UMATILLA COUNTY, OREGON

COUNTY ENGINEER'S OFFICE


COUNTY ROAD NO. 867

LOCATED LINE

SCALE = 1" = 400 FT.    OCT. 1926

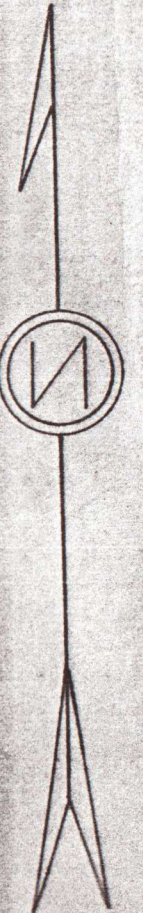

12

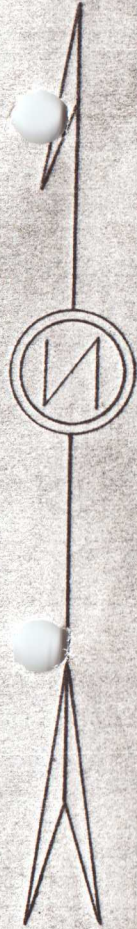

11° C.L.  
Δ = 25° 41'  
S.T. = 118.7

0+10.8 P.C.

2+452.2 P.T.

30' 13"

N64°13'E

T4N. R28. E.W.M.

64° 25'

29+22.0

T4N. R29. E.W.M.


3610.90 P.C.

1° C.R.  
Δ = 7° 52'  
S.T. = 394.0

43+92.7 P.T.

45 7055  
49+38 191 50  
64 977 50  
1310 57 00

0+00.0  
ing of Project.

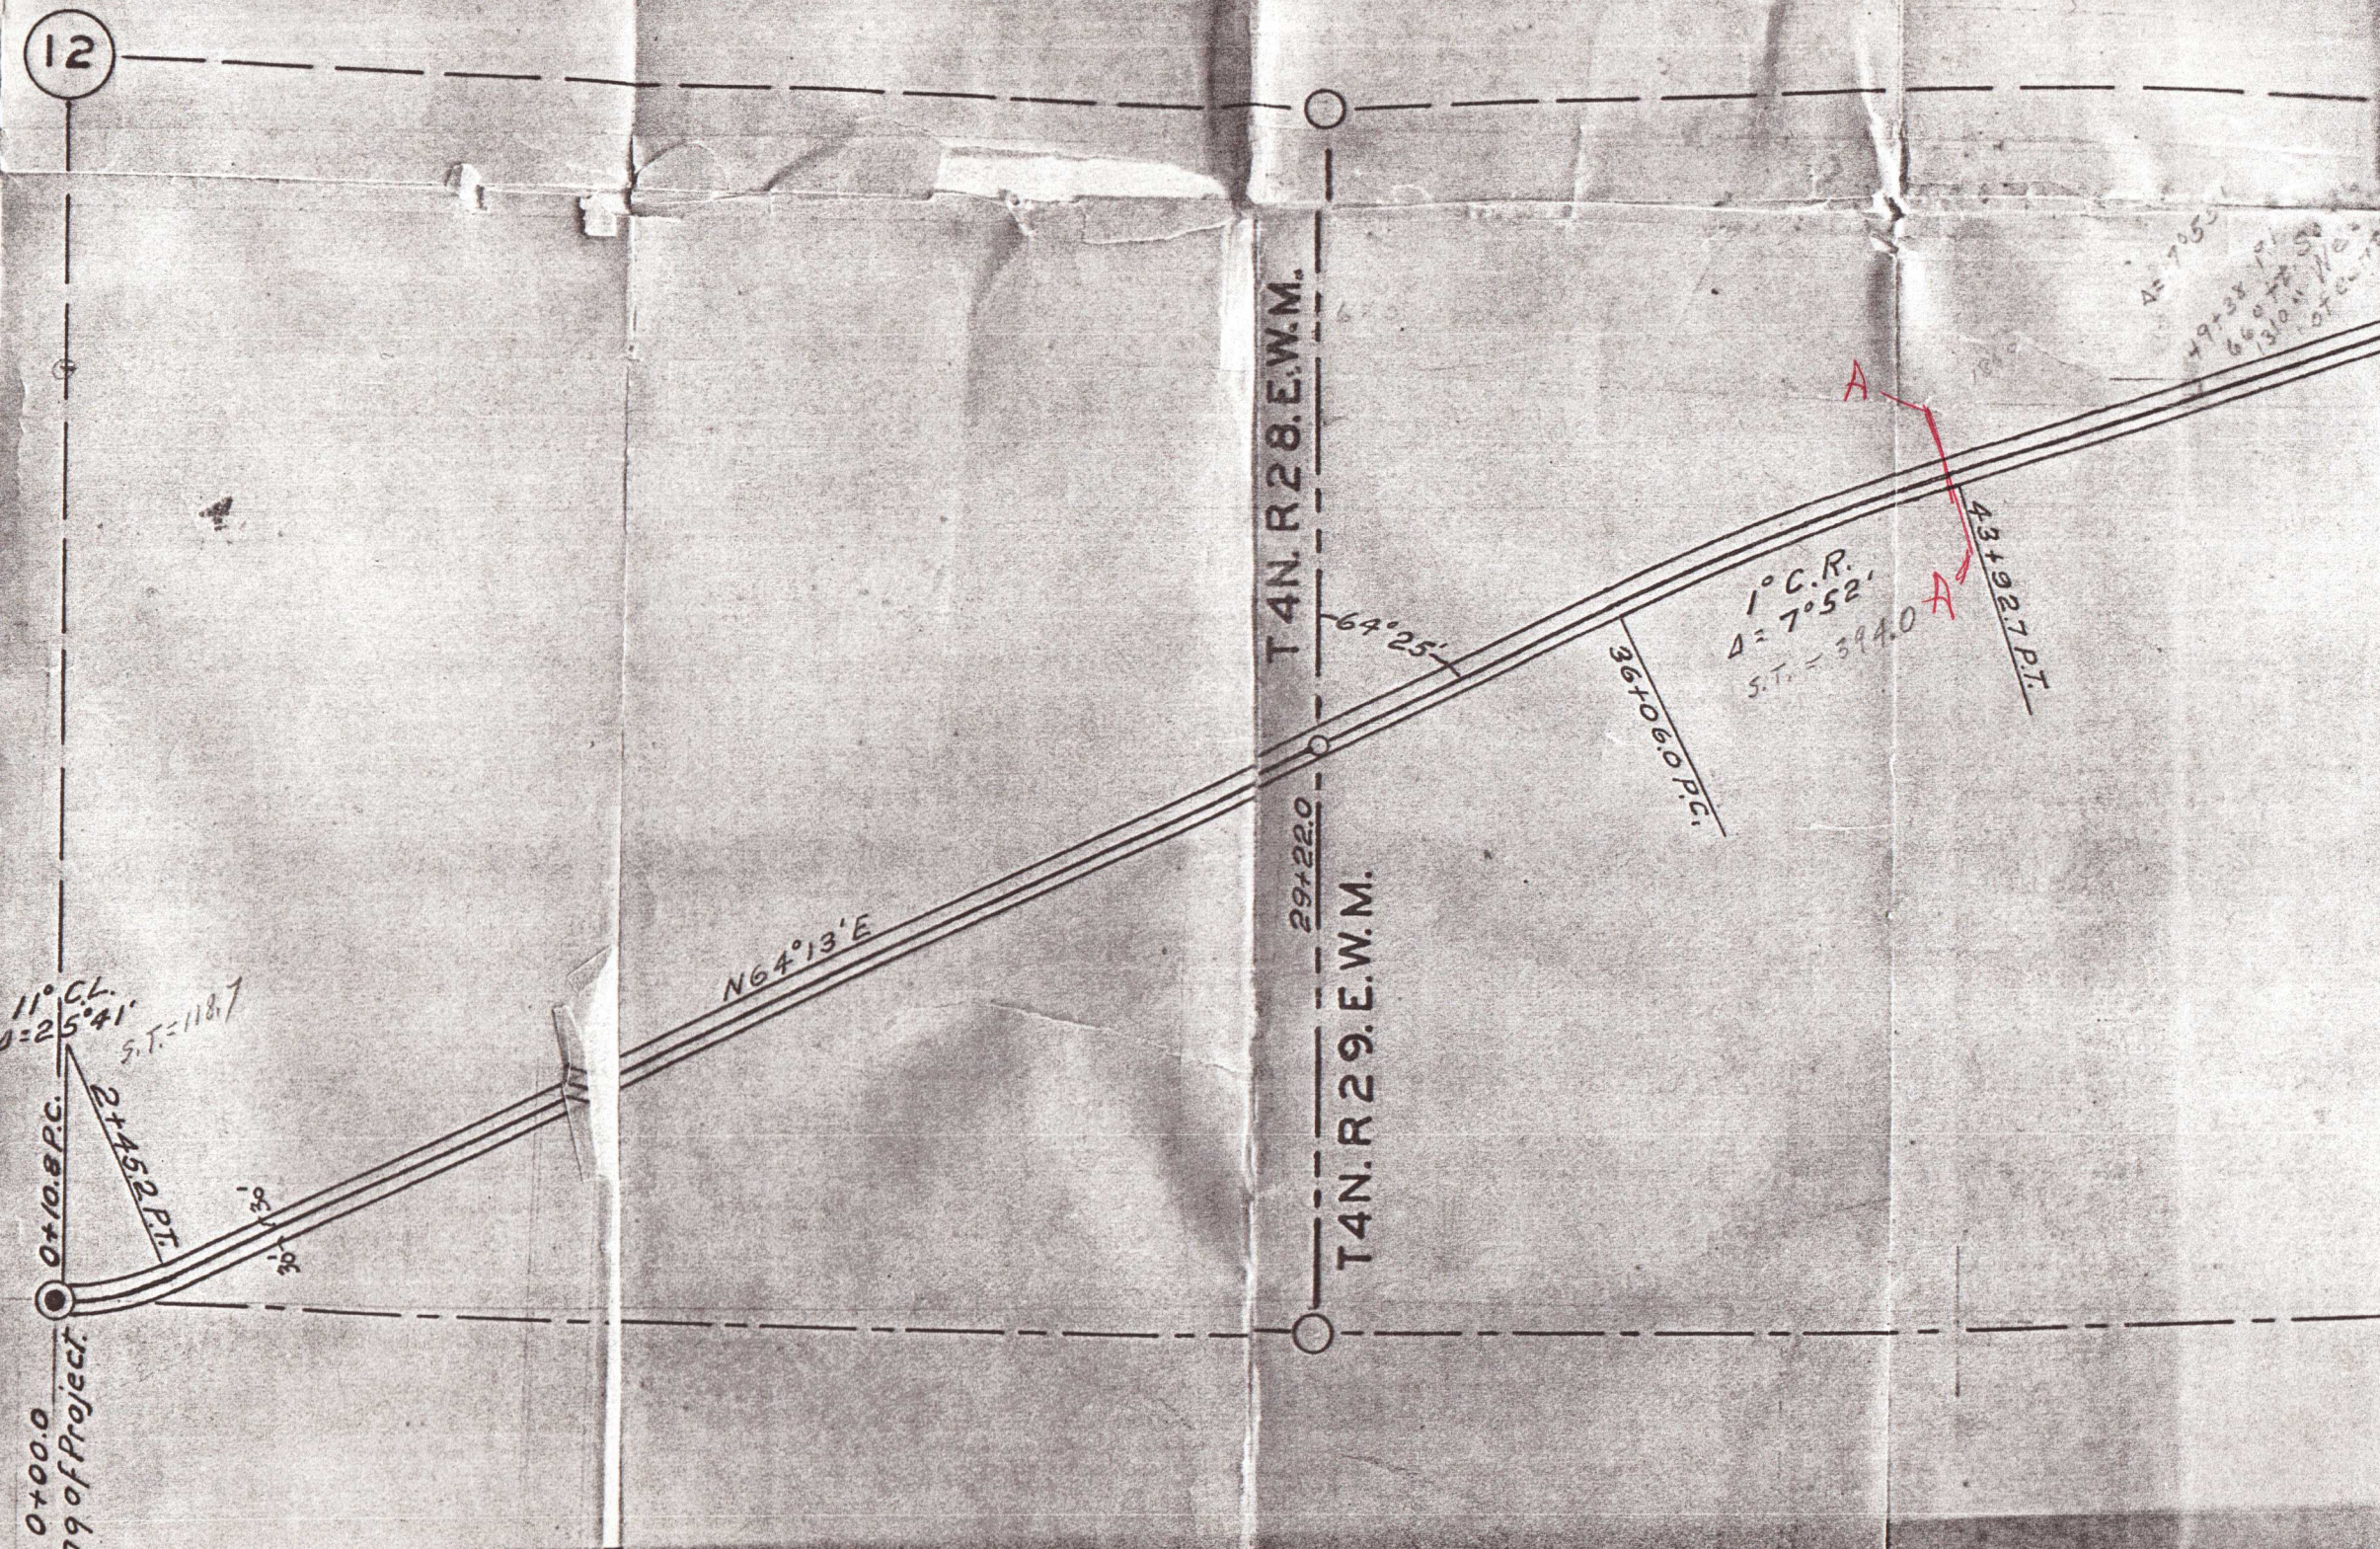

3610.60 P.C.

1° C.R.  
Δ = 7° 52'

S.T. = 394.0

431.927 P.T.

A = 7° 52'  
1973 pt  
660 + 750  
1310. W of center

631.69

10


2882  
72267

N 72° 05' E

90+798

90

90

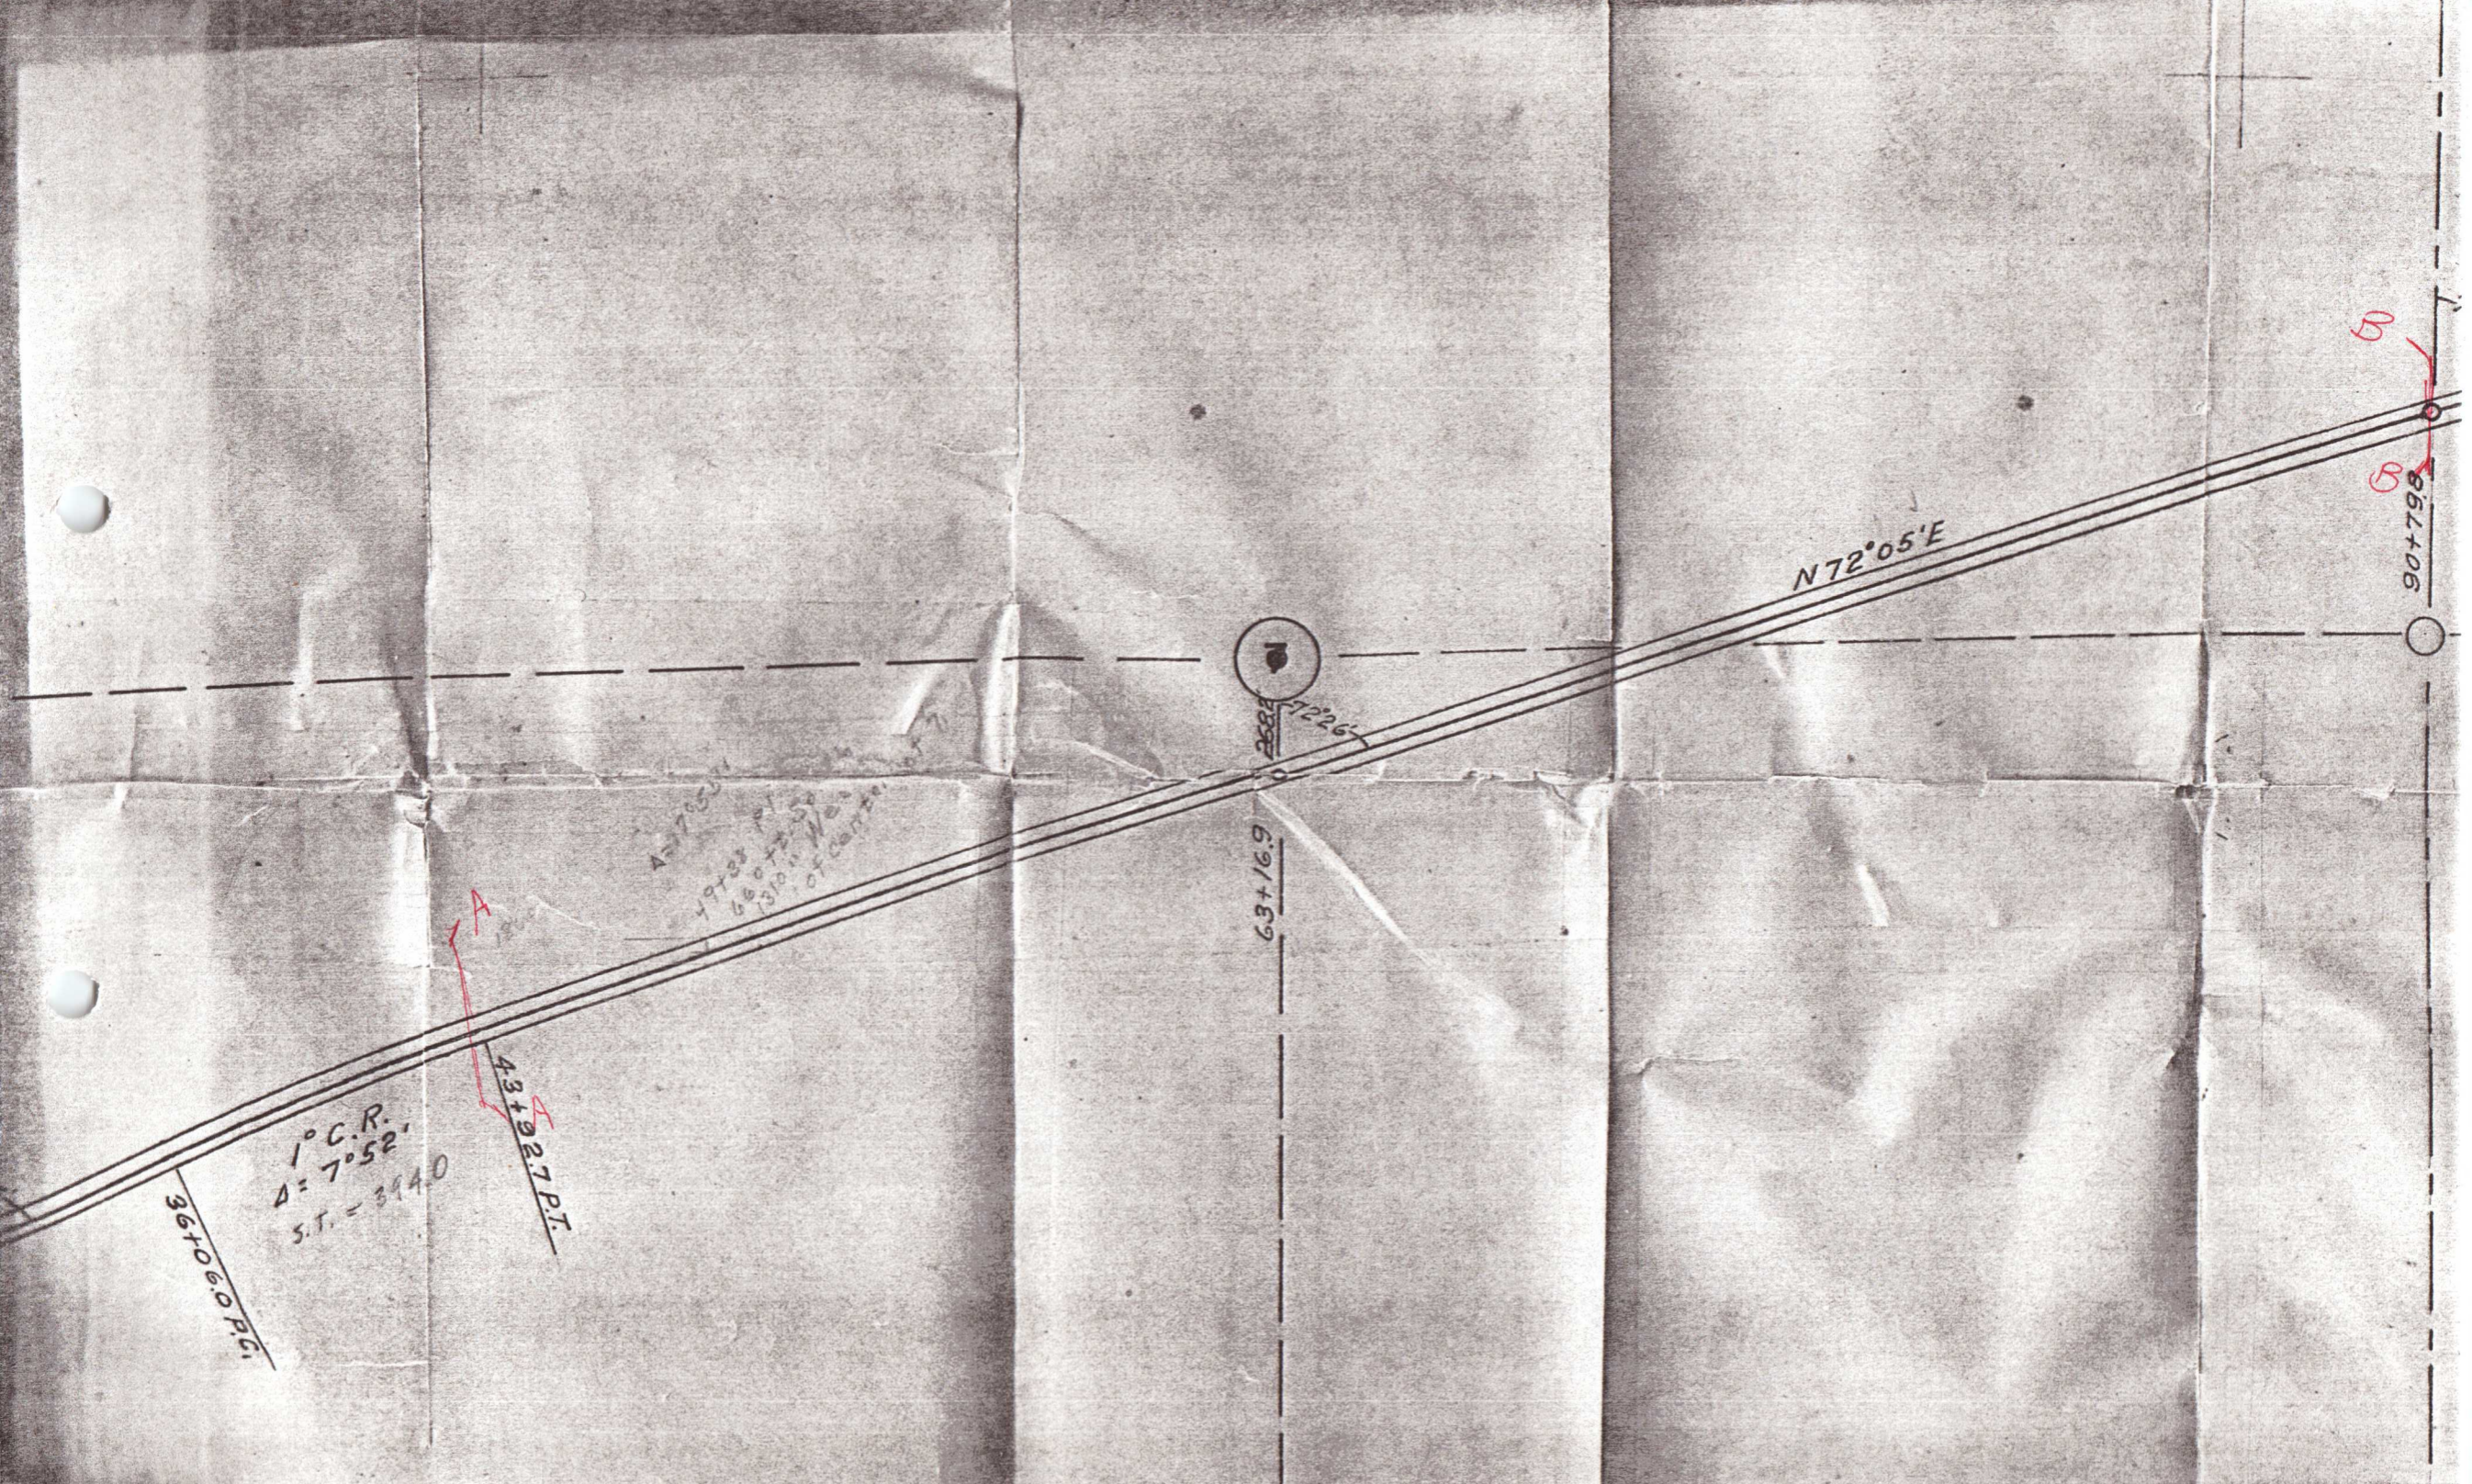

90+79.8

72°28'

10° C.R.  
D=16°43'

Government feed Canal

110+64.3 PT.  
108+17.6

N88°48'E

36+130'


142+63.3 P.C.


4° C.L.  
D=10°54'

145+35.8 P.T.  
145+35.8 P.O.S.T.

1586.5'

8

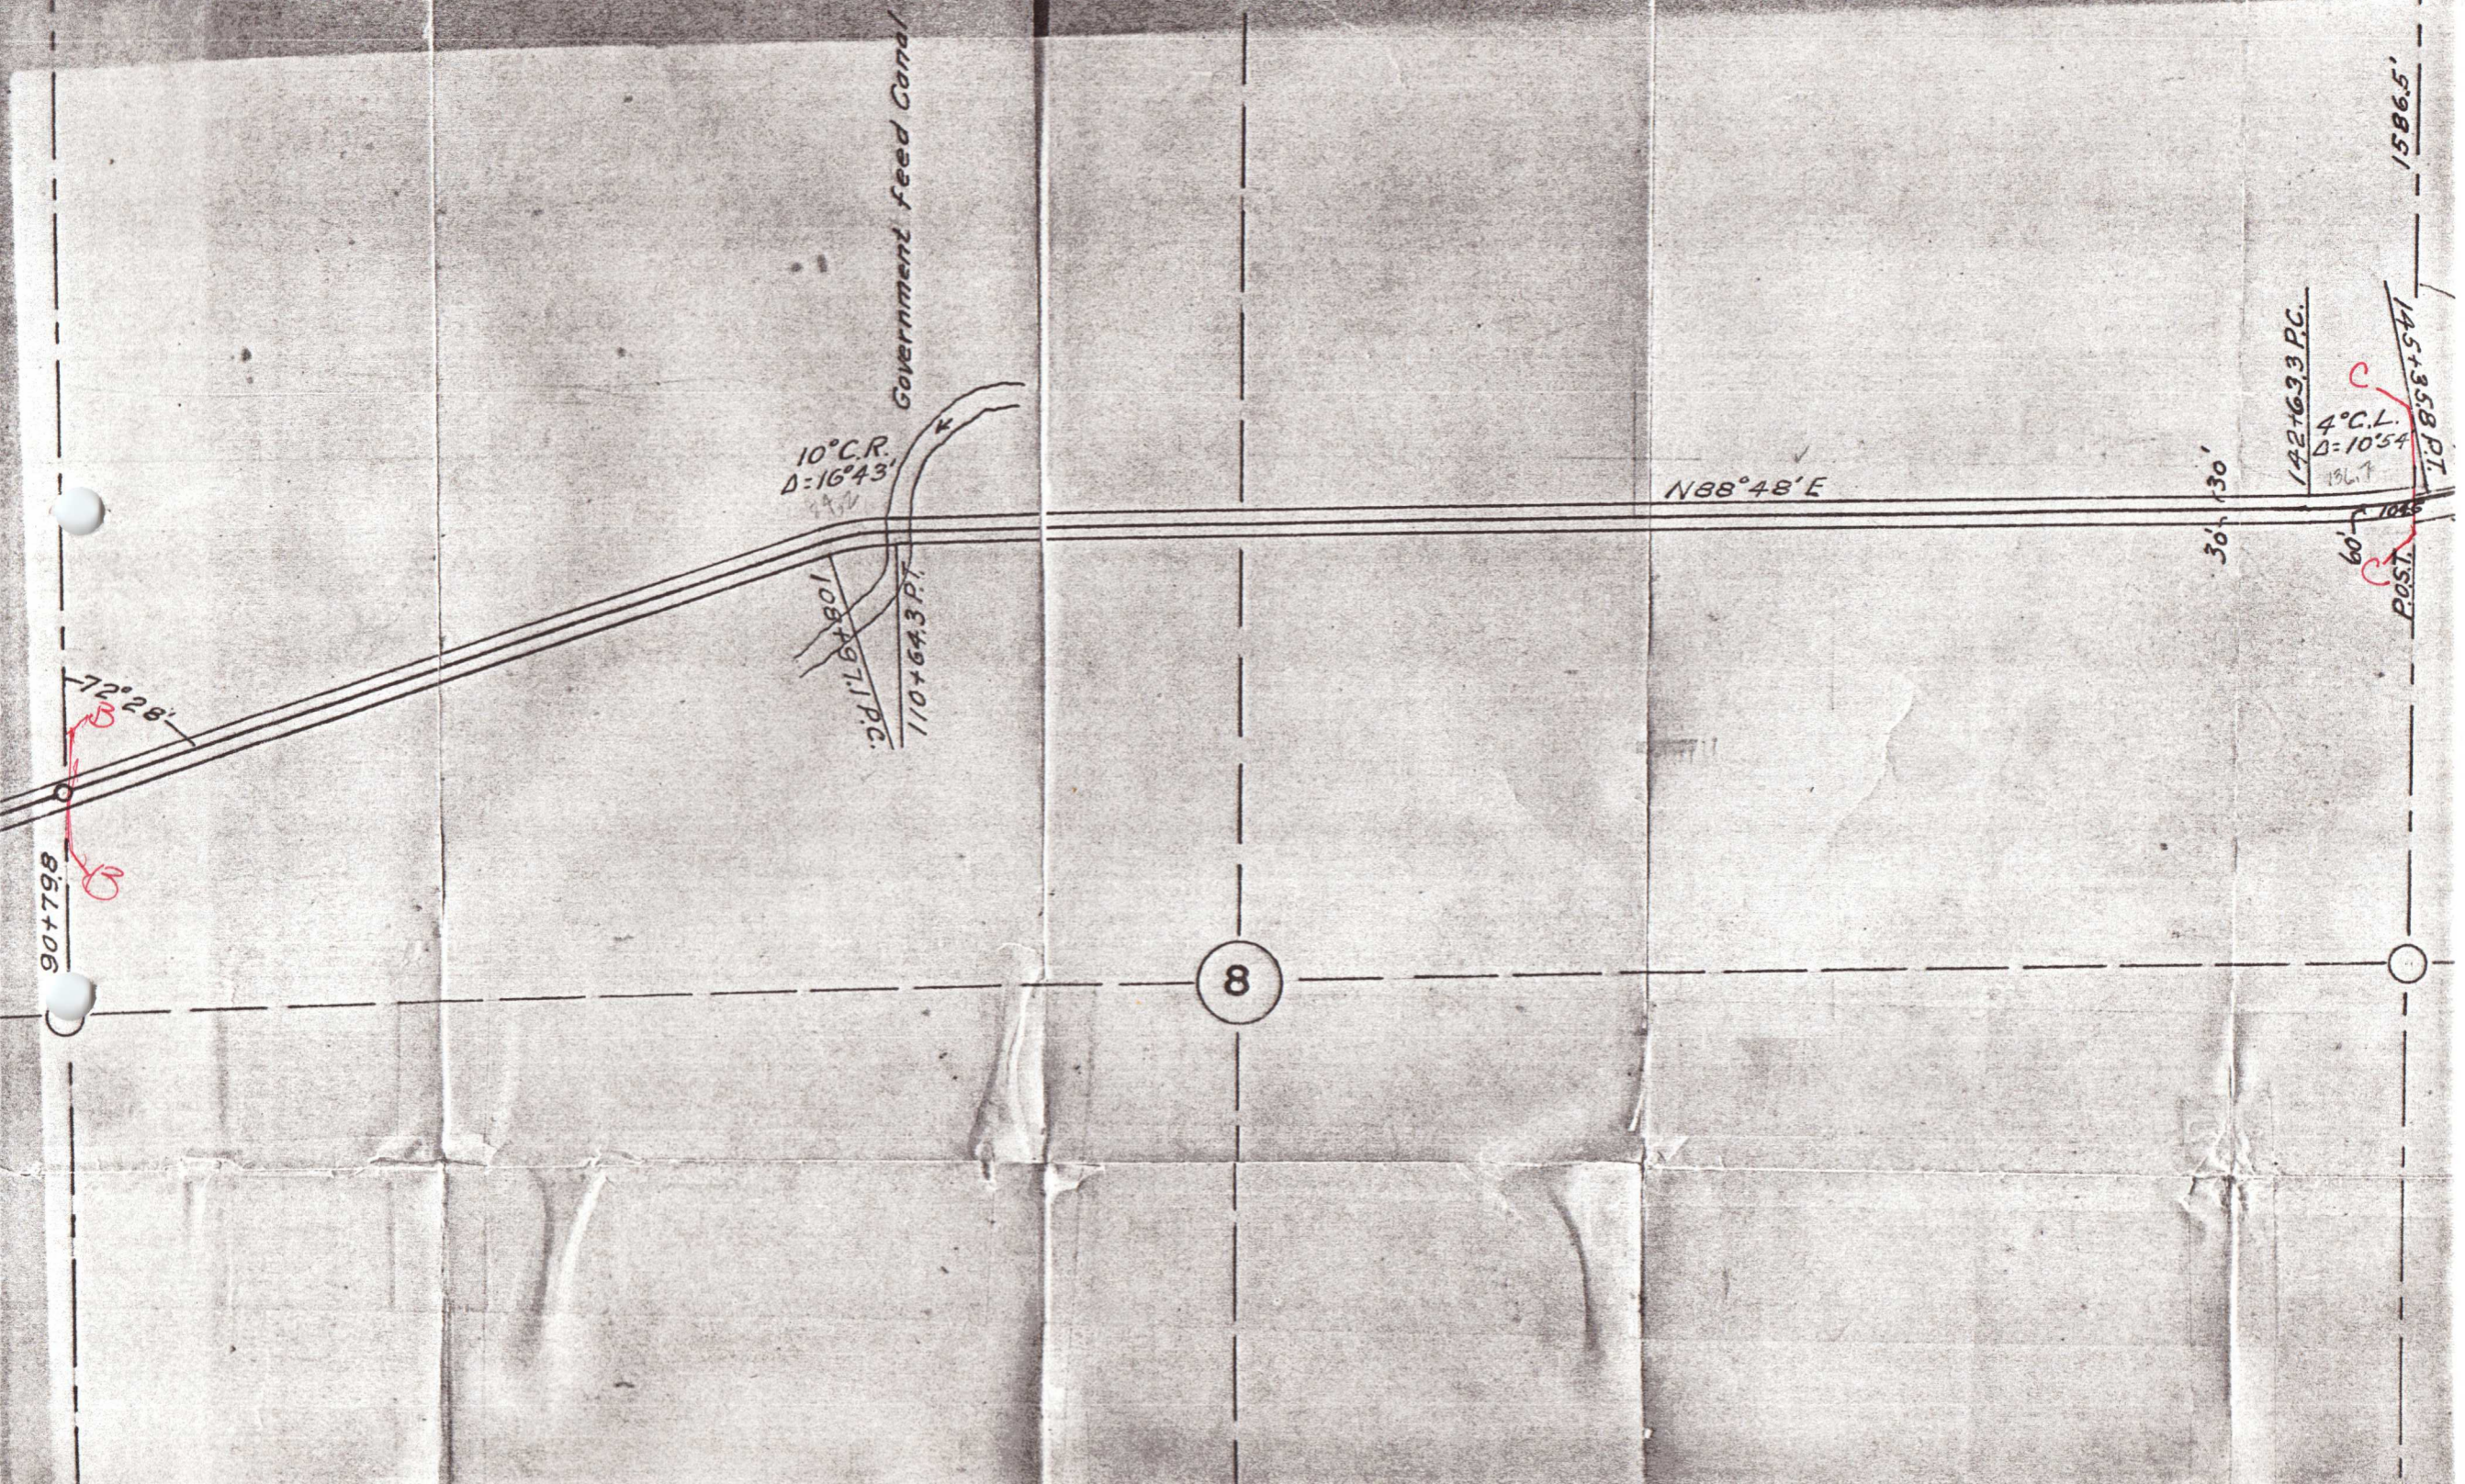

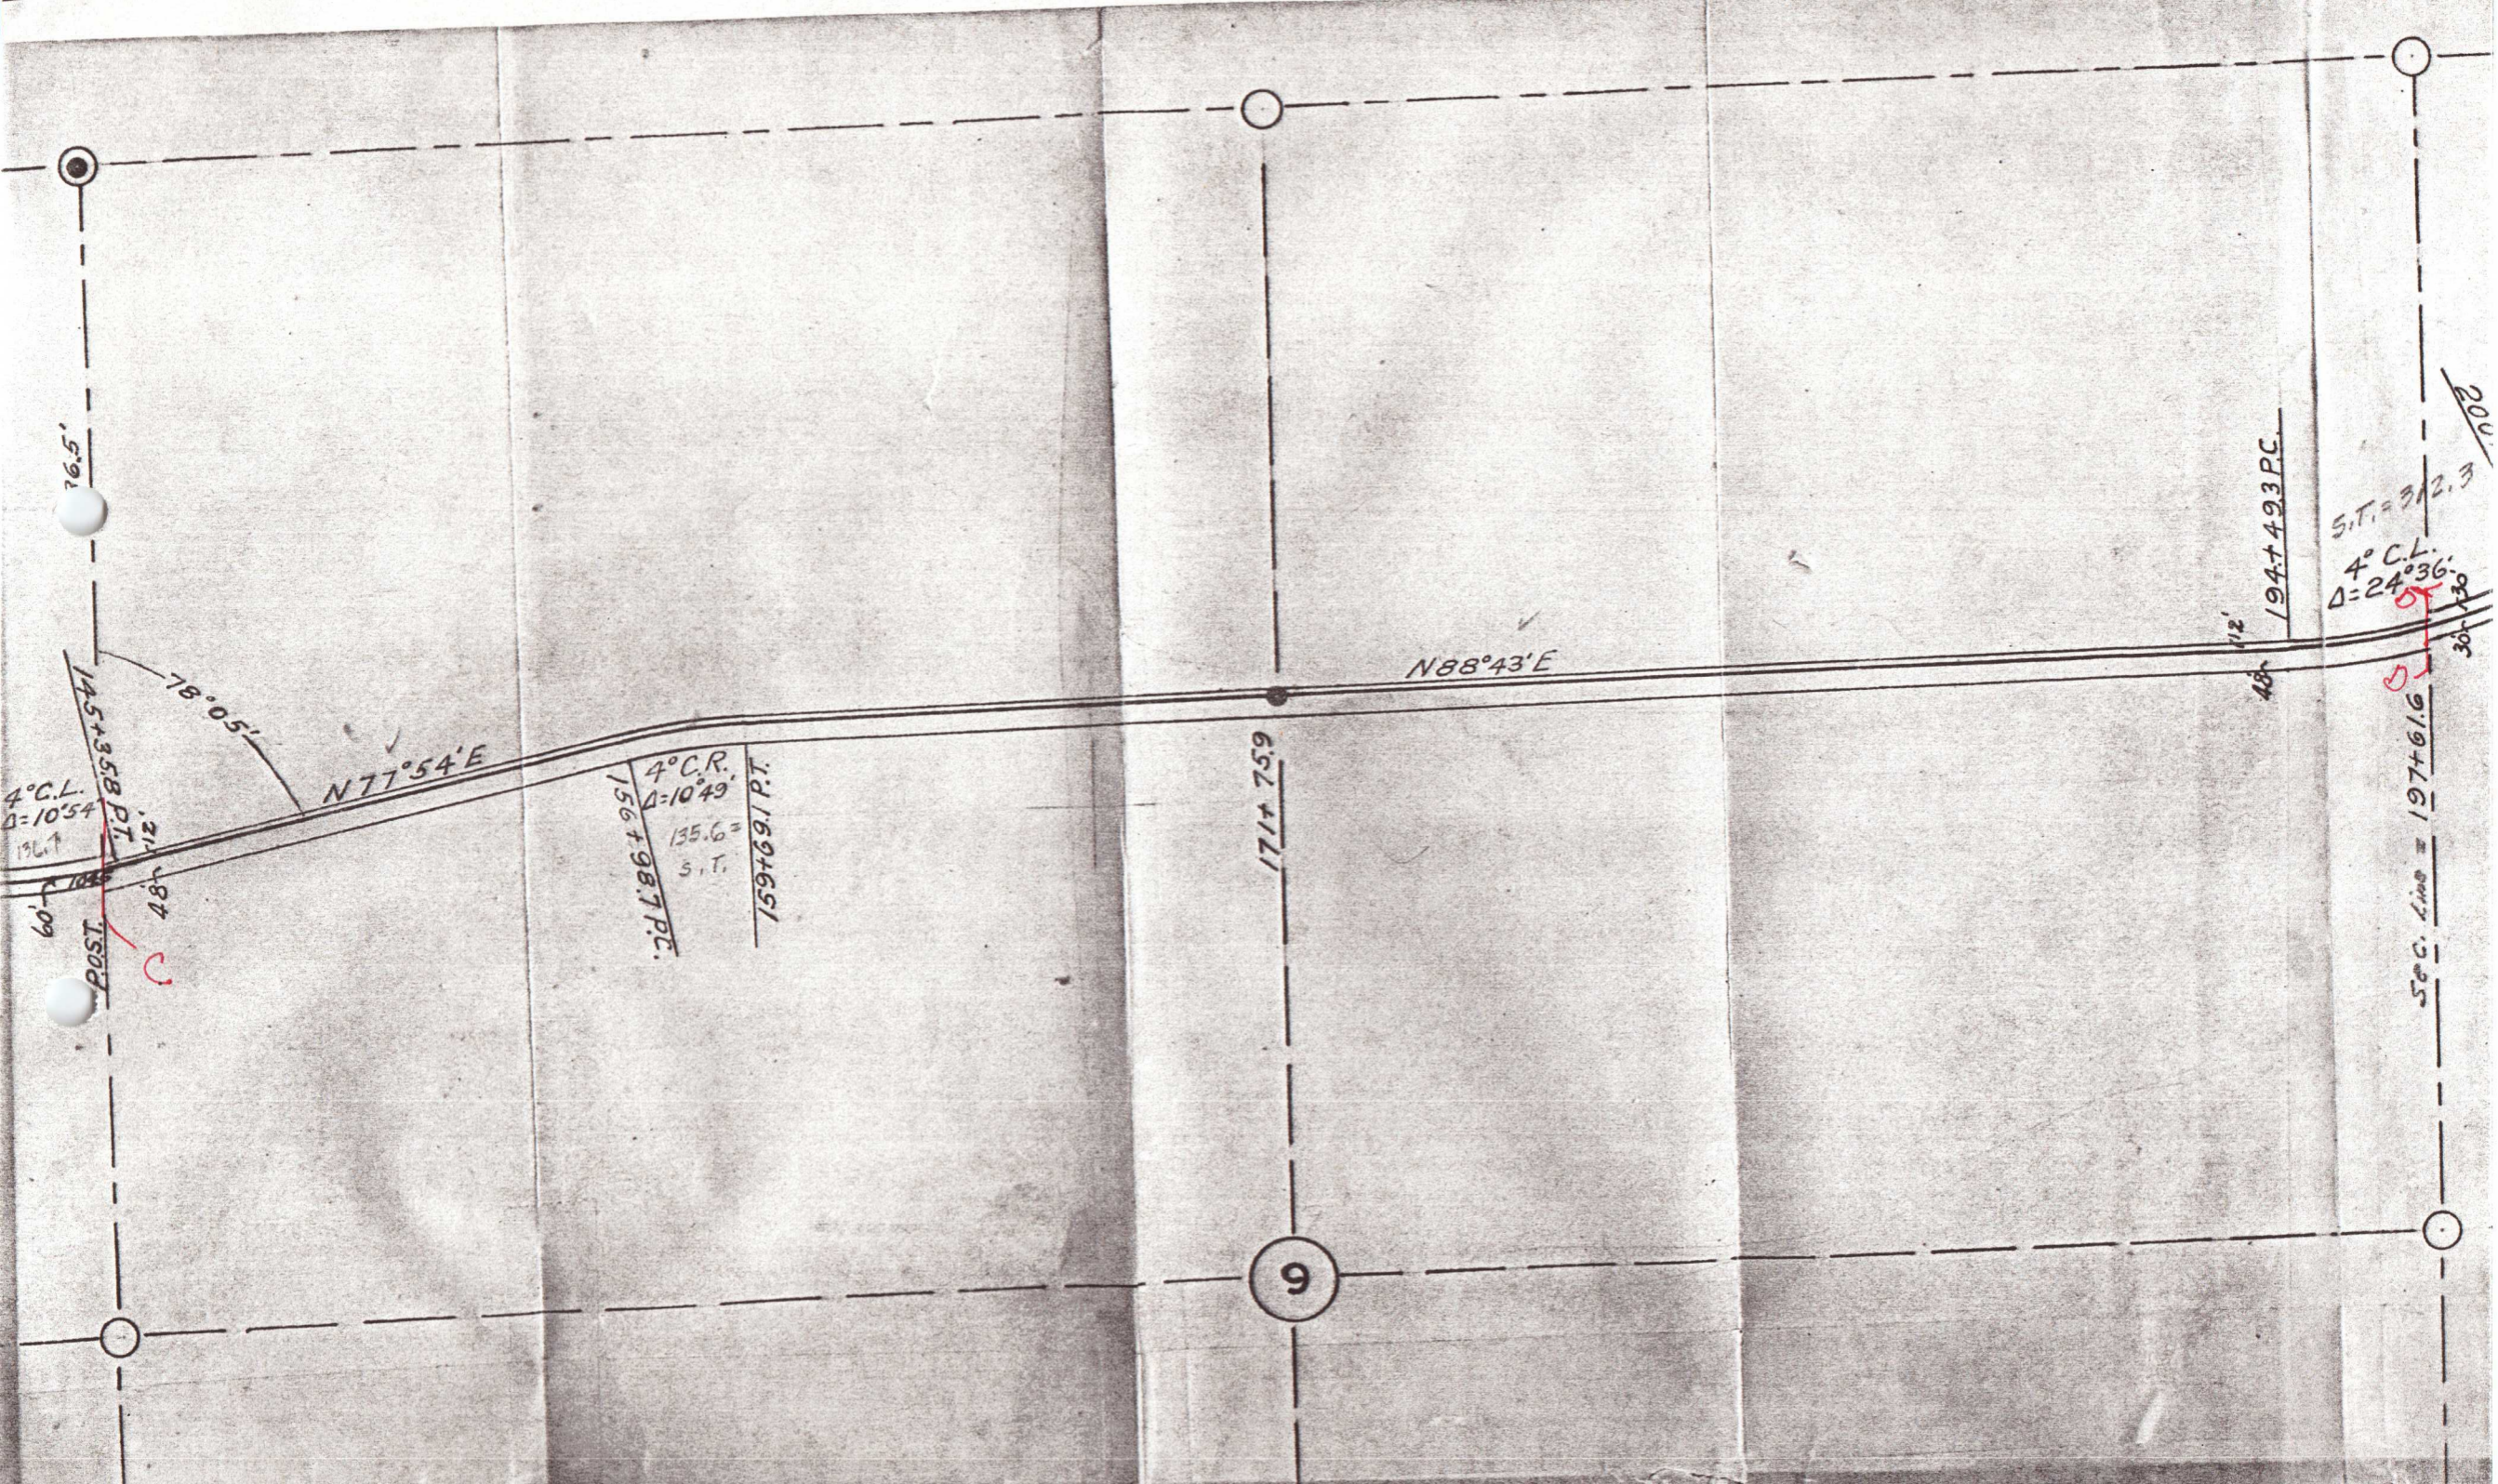

76.5'

4° C.L.  
D=1054'

POST

145+358 P.T.

78°05'

N77°54'E

4° C.R.  
135.6 =  
S.T.  
156+98.7 P.C.  
159+69.1 P.T.

N88°43'E

171+75.9

9

194+493 P.C.

4° C.L.  
D=24°36'

5° C. Line = 197+61.6

S.T. = 312.3

200

30

130

ST. = 312.3  
4° C.L.  
= 24° 36'



203+311 P.I.  
200+936 P.C.  
D = 14° 15'  
E = 119.4

N 78° 22' E

212+849 P.C.  
214+554 P.T.  
40° C.R. D = 68° 42'  
ST. = 97.0

S 33° 26' E


216+821 P.C.  
219+705 P.T.  
20° C.L. D = 57° 41'

N 88° 53' E

10

226+18

252+780 P.T.  
0' 19" RT.

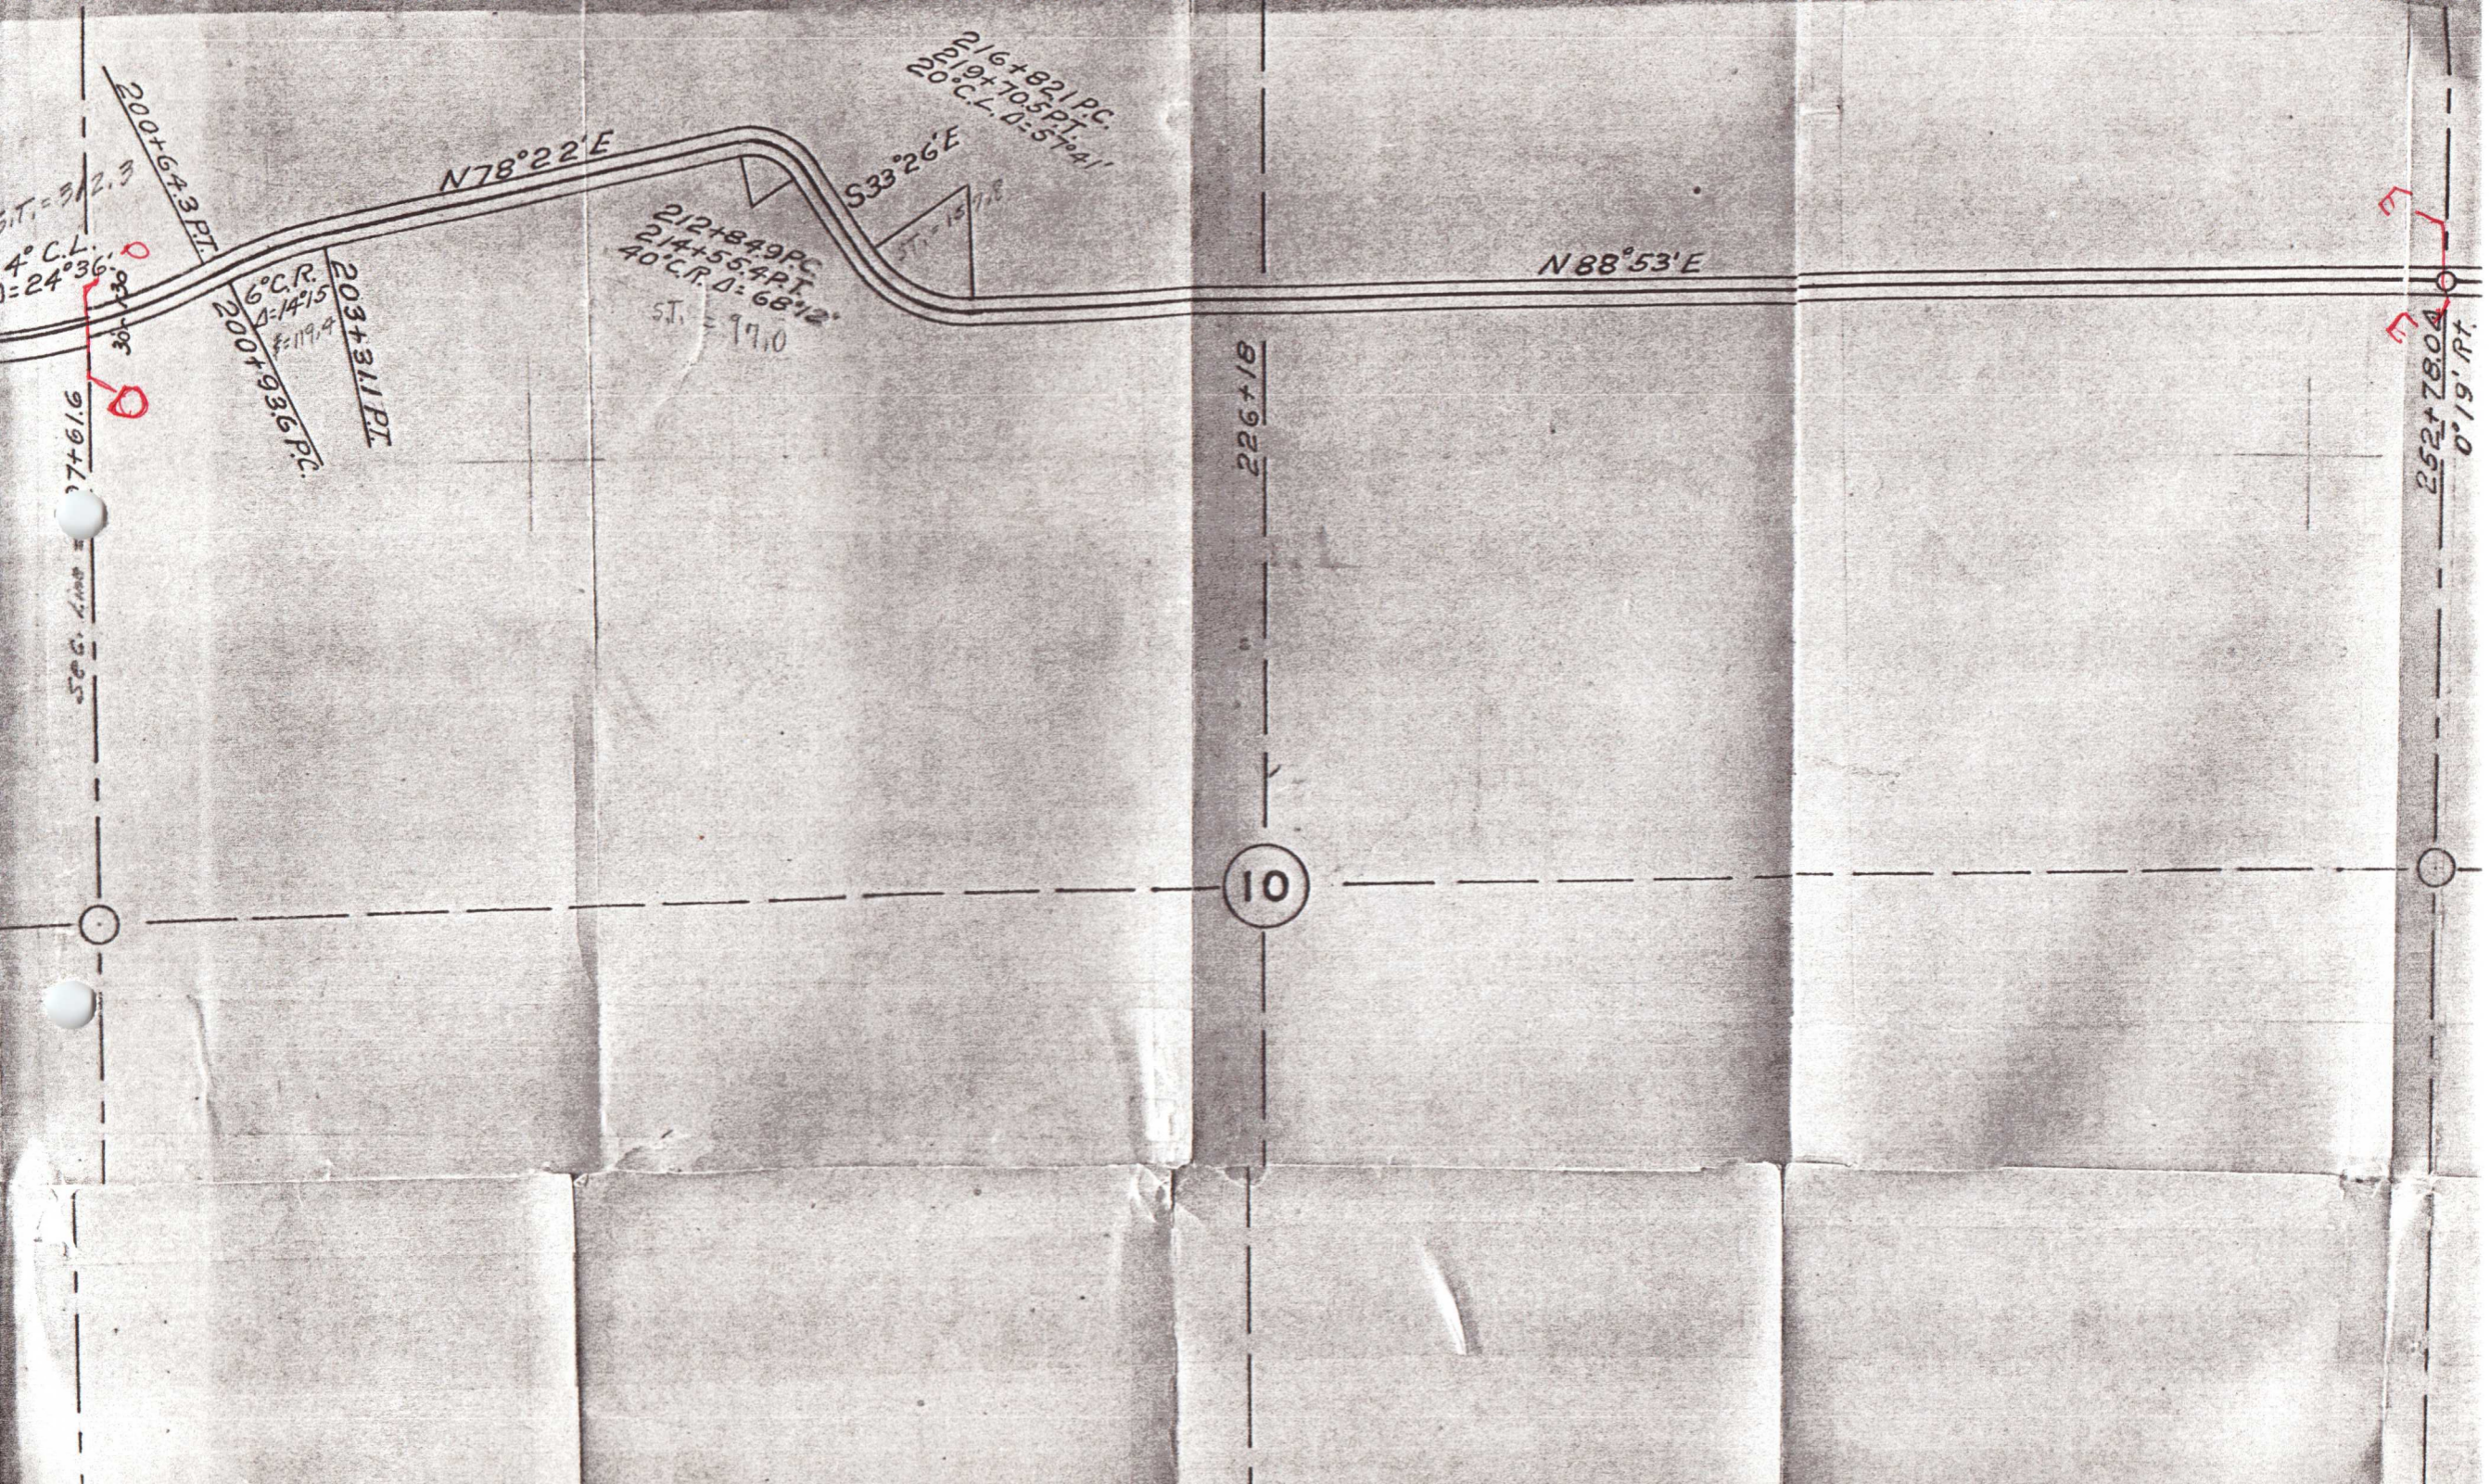

252+78.04  
0°19' FT.

N 89°12' E

279+33.1

302+81.2 P.C.

10° C.P.  
D=56°50'

308+495 P.T.

305

