


643

PLAT of Part of Road No. 683

T. 4. N. R. 29. E. W. No.

Red shoing Portion to be vacated. Blue shoing 40ft. to be a public Highway

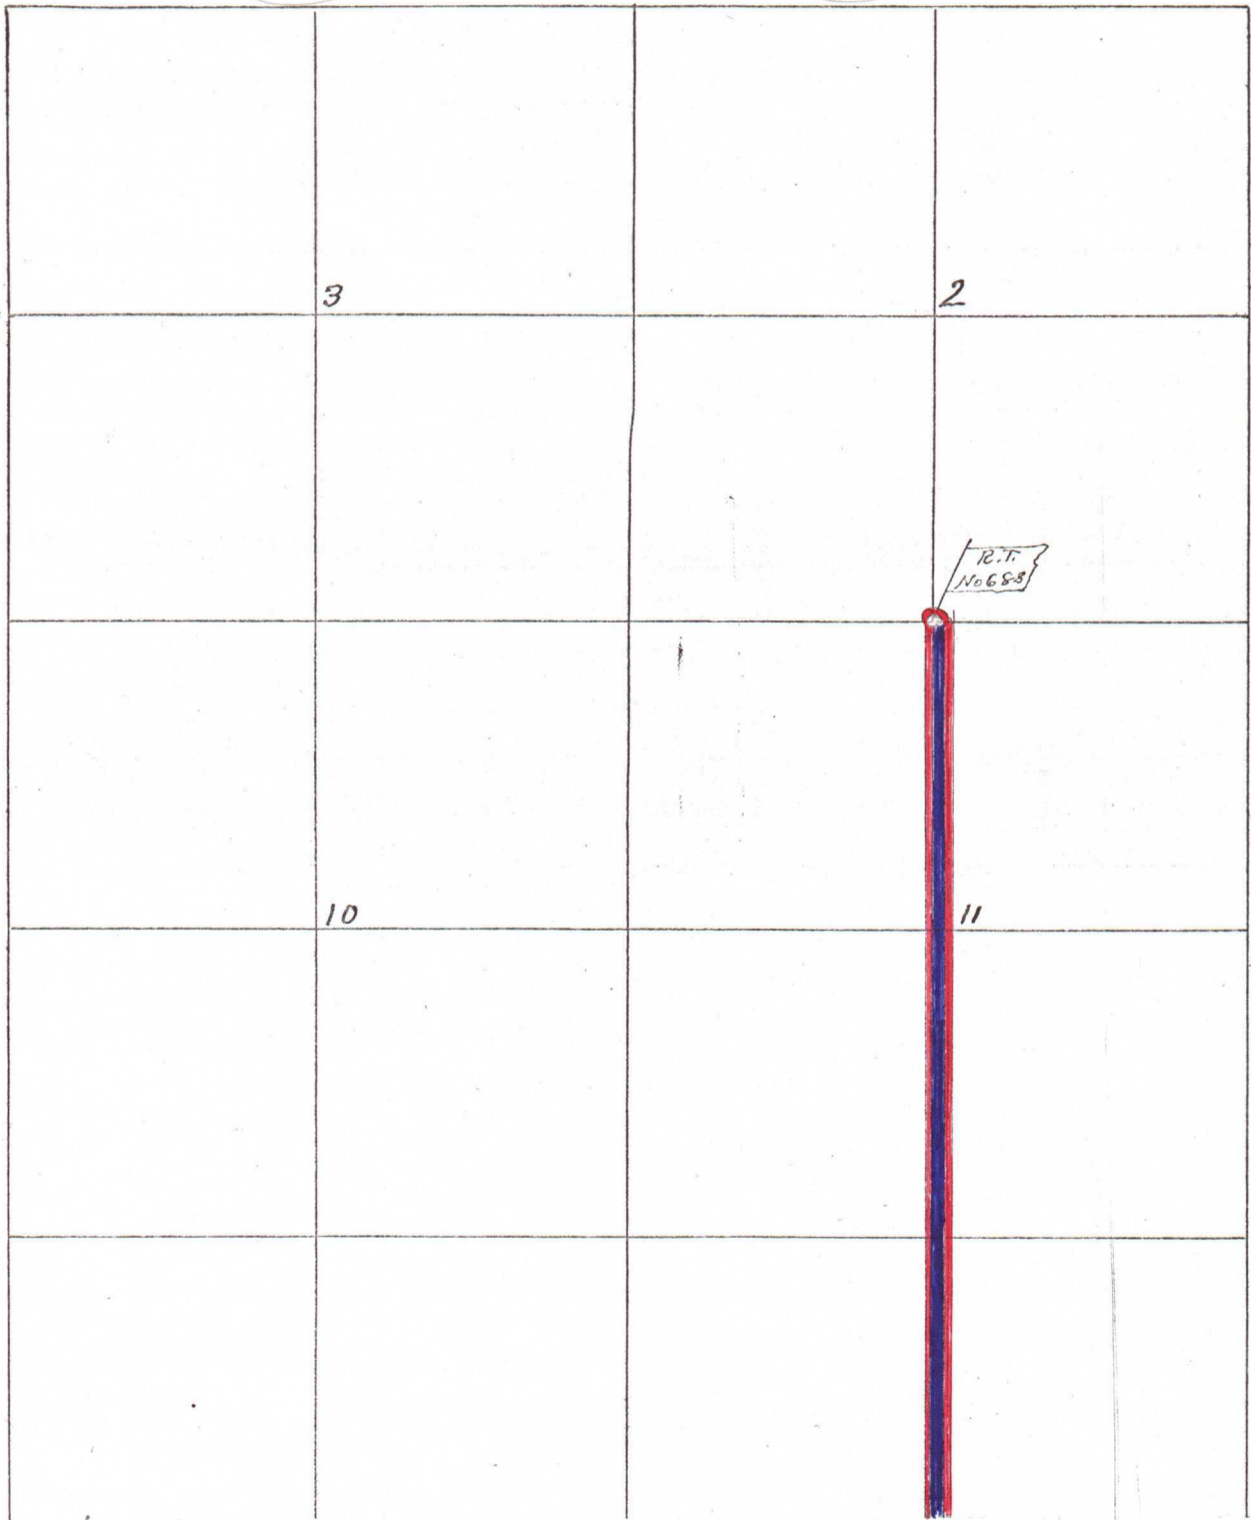

683



True Meridian
Var. 21° 30' E
Scale 25. ch^s 1"