

Report Field notes & Plat of Bounty  
 Road from S.E. cor of Sec 30. T.H. N.R.  
 33 E. to Cold Spring Landing. begun  
 Aug 30<sup>th</sup> 1880

To the Hon County Court Wm. Miller County  
 Oregon. we the undersigned. viewers appointed by  
 your Hon body to view out and survey a bounty Road  
 from S.E. cor of Sec 30 T.H. N.R. 33 E to Cold Spring Landing  
 on the Columbia River would respectfully report that  
 we met at the time and place appointed and calling  
 to our aid B.F. Raley as marker and Jas Wells & Wm Shaper  
 as chainbearers. who were each duly qualified by  
 Jno S Arnold surveyor. we proceeded to view out and  
 survey said Road. we would further report the Road  
 located on the most practical route and much needed  
 and we would recommend that the petition for said  
 road be granted

J Wells  
 Jas. Jones } viewers  
 J R Porter }

Field notes to Road from S.E. cor of Sec 30. T.H. N.R 33 E to  
 Cold Spring Landing begun Aug 30 1880

- Var 20° E set initial Post at S.E. cor Sec 30 T.H. N.R. 33 E
- W 40<sup>ch</sup> along line bet secs 30 & 31 to 1/4 sec cor bet same
- N 80 through center of Sec 30. set 1 m P in bottom of Jos Millers Res
- " 46.50 " " cent sec 30 to 1/4 sec cor bet secs 19 & 30 passing through lane
- W 75.46 to cor for Secs 24, 25, 19 & 30
- " 80 set 2 m P on N hill side in lane E of Mr Kendalls Res
- " 35.24 to 1/4 sec cor bet secs 24 & 25

3M

- N 60° 30' W 80<sup>ch</sup> set 3 m P on N side of flat near Cargills Res
- " 26<sup>ch</sup> set angle stake on N side of flat opposite Ravine on N

4M

- N 67° W 65 set a S at foot of bluff on N side of Cold Spring cañon
- N 65° W 80 set 4 m P in N side of flat gulch N
- " 4.50 set a S in flat cabin bears S 21° E

5M

- S 86° W 57.50 down cañon set a S in flats E of Keeney & Wulevans lane
- N 88° W 80. set 5 m P. on S side of laid out Road near K & W Res
- N 70 W 31.50 down cañon set a S opposite ravine N
- N 81° 30' W. 52 " " S side of cañon
- W 80 down cañon set 6 m P in flat ravine on N side of cañon

6M



Rd #79 41 N 5° W <sup>ch ek</sup> 64.50 down canon set a S N side of canon  
 15M 42 N 55° 30' W 80 " " " 15m P left of trav R in canon  
 43 N 6° W 21 " " " a S left of trav R canon on E  
 44 N 67° W 36.50 " " " " at mouth of canon on right  
 45 S 73° W 53.50 " " " " left of trav R  
 46 N 65° W 70 " " " " Right " " "  
 16M 47 N 58° W 80 " " " 16m P left of trav R  
 " " " 27 " " " a S " " " "  
 48 S 72° W 55 " " " " " " " " R coming in on Rt  
 49 S 83° 30' W 69 " " " " near fence Badger Springs  
 17M 50 S 35° W 80 through field set 17m P in field at " "  
 51 S 20° W 18.59 down canon set a S at mouth of bovel spring, canon  
 52 N 89° W 42. " " " " right of trav R  
 18M 53 S 81° W 80 " " set 18m P. N side of trav R  
 " " 8.50 " " " a S N side of canon  
 54 S 45° W 43.27 " " " " S " " "  
 55 N 79° W 72 " " " " S " " trav R  
 19M 56 S 57° W 80 " " " 19m P right " "  
 ✓ S 57° W 23 " " " a S right of trav R  
 57 N 66° W 40 " " " " left " " "  
 58 N 73° W 53.50 " " " " right " " "  
 59 S 66° W 77 " " " " left " " "  
 20M 60 N 67° W 80 " " " 20m P rt of trav R small canon on N  
 " " 14.50 " " " a S " " " " near rock Bank  
 61 S 50° W 36.50 across. " " " " on hill side. S of trav R  
 62 N 81° W 61 " " " " on hill N side of canon at 20 m P. summit R  
 63 N 23° W 68.58 " ravine on N side of S canon set a S at sand hill side of trav R  
 21M 64 N 69° W 80 over panel ridge set 21m P on ridge left of trav R  
 65 N 37° 30' W 57.14 over prairie set a S left of trav R  
 22M 66 N 52 W 80. set 22 m P Rt of trav R  
 " " 16.50 " a S left " " "  
 23M 67 N 43° W 80 " 23 m P " " " "  
 " " 12 " a S about 8 rods to left of trav R  
 68 N 46° W 71.50 " " " on sand hill side. left of trav R  
 24M 69 N 69° W 80 down hill set 24 m P in Rock rt of trav R  
 " " 10 " " " a S on panel hill. N of Rock cliff  
 70 N 44° 30' W 32.50 " " " " " " S of trav R  
 71 S 86° W 51 " sand hill set a S S of trav R at turn to N  
 72 S 20 W 71.50 " " " " " " on sand hill S of Ravine

mmL

25M Rd #9


25M 73 N 75° 30' W 86<sup>ch</sup> across sand hollow set 25 m P on sand ridge. Pt of  
 " 19 down sand hill set a s. in sand bench of Simmons Res  
 74 N 21° W 34.50 " " " To Simmons landing pt terminus P  
 whole distance 25 m. 138 R0

The stakes and posts were all marked and mounded as directed by law. Road well marked by travel

B. F. Raley (marker)  
 Wm Shafer } chain men  
 Jas G Wells }

Jno G Arnold

Surveyor

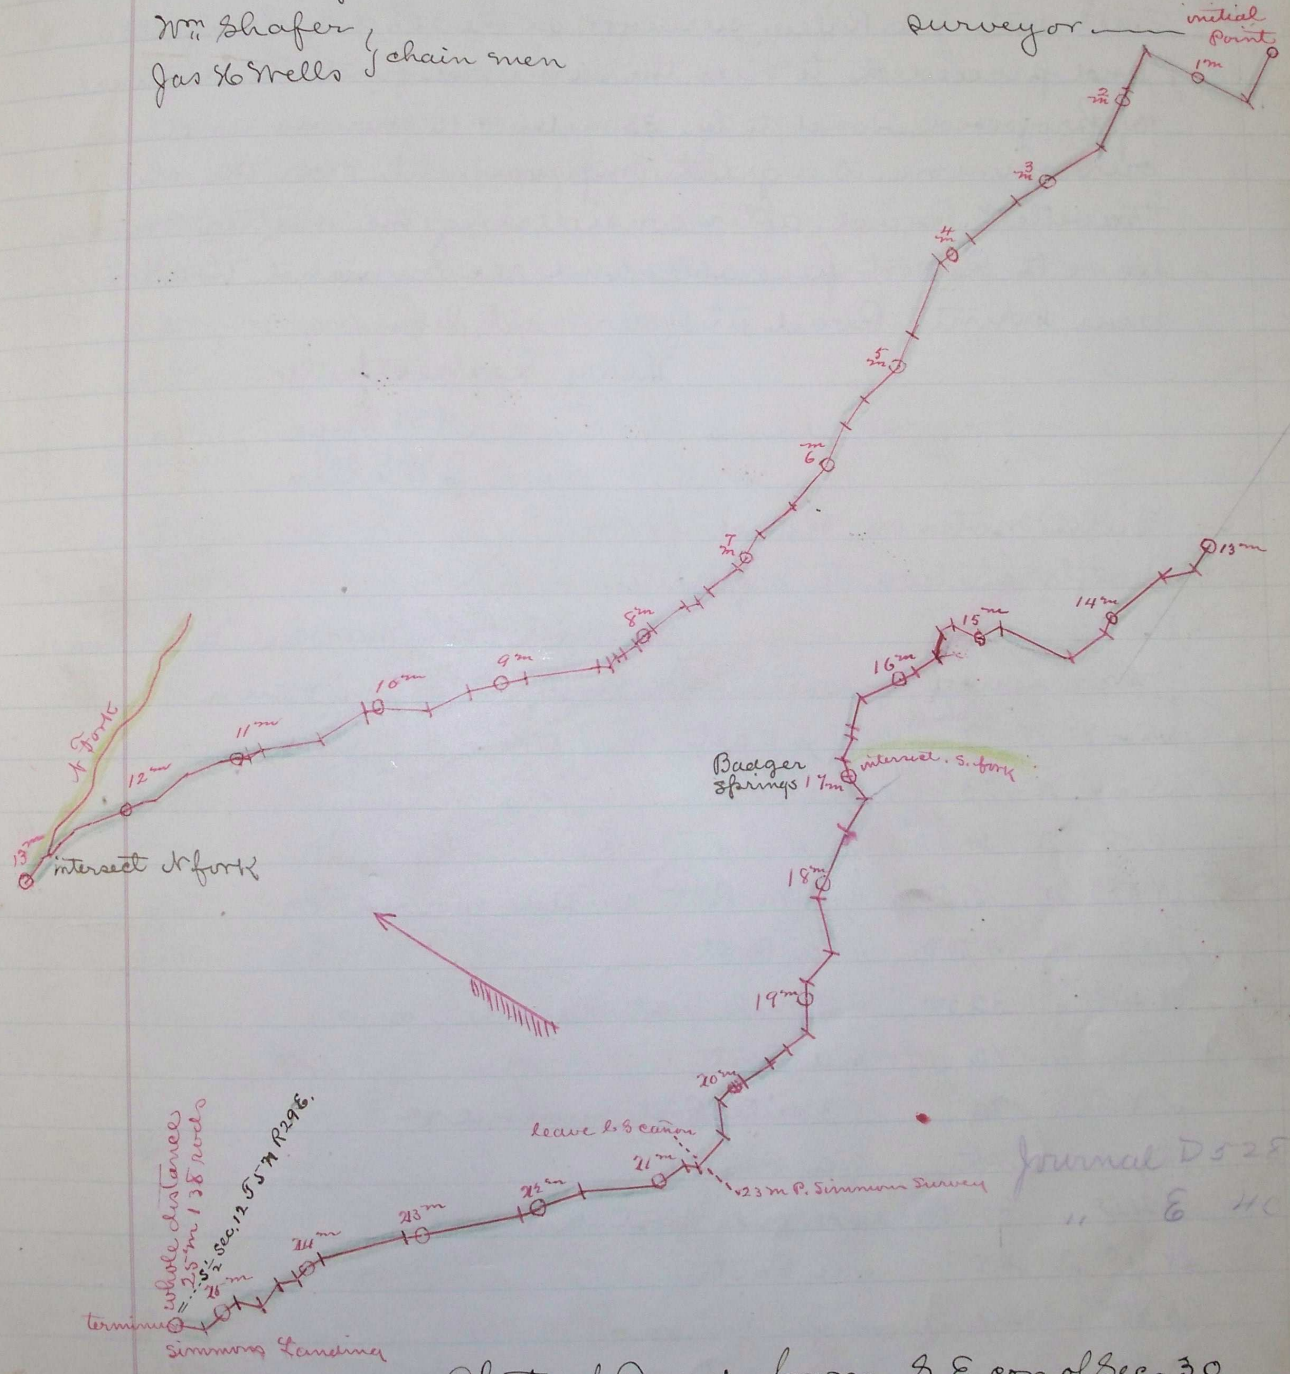

Journal 10 603  
 " 8 40

Plat of Road from S.E cor of Sec 30  
 T. 4 N R 33 E to Simmons Landing on  
 Columbia River. Scale 80 chains to inch

J G Arnold

Opdy to Surveyor

Recorded sept 23<sup>rd</sup> 1880

H. Keeney clk

Journal D 528  
 " 8 40