

ROAD NO

397

Road 397

In the matter of Viewing, Surveying and laying out County Road No. 397. Commencing at a point on the east bank of McKay Creek, when the center of the east end of the upper County bridge across said creek joins on to said bank, and from said initial point running northwesterly along down the east side of said creek as nearly as practicable to the bluff or highland bordering said creek bottom, to and across the road leading from Pendleton to the lower bridge across said creek, thence along the east line of fence around the field of G.A. Hartman, thence continuing along down said fence, to where the said fence joins the east line of the fence on the farm of G.H. Raley, thence along down the said east line of Raley's fence to the intersection of the road now leading from the Residence of G.H. Raley on said McKay Creek to Pendleton thence in a northeasterly direction following said road or as nearly straight as a good practicable road may be obtained, to a point on the north line of Sec 16 Tp 2 NR 32 E 1 W 80 rods west of the N.E. Corner of said Section; thence in a northeasterly direction along the most practicable route for a County road to a point on the south bank of In La Willow Creek where the south end of the County bridge across said creek joins on to said south bank.

Report of Viewers

To the Honorable County Court of the State of Oregon, for Umatilla County We, the undersigned, the Viewers heretofore appointed to view and locate road no 397 submit the following report: Pursuant to an order of the Honorable Court we met Geo. C. Arnold County Surveyor at Court house on the 9th day of June 1892 and were by him, each, duly sworn to faithfully and impartially discharge the duties of our appointments.

We called to our aid J. M. Jarvis } chairman.

J. C. Hill

do Marker.

who were by the Surveyor, each, duly sworn. We viewed surveyed and located said road no. 397 as specified in our order, as near, as in our judgment a good road can be made. we find the road to be of great use to the public being now much traveled. The road as viewed out and surveyed by us, is located upon the best grades and the best ground to be found along the immediate route, described in petition for the same. The road will be comparatively easy to open and keep in repair; we would therefore recommend that said road 397 be declared a public highway

Course	Dist
N 11° 37' W	0
N 46° 34' W	55
	80
N 31° 09' W	14.
N 23° 24' W	20.
N 41° 54' W	28
N 44° 31' W	39.
N 34° 53' W	58
N 24° 53' W	66
N 19° 08' W	70
	75
	80
N 25° 25' W	14.
N 22° 55' W	19.
N 7° 20' E	23.
N 70° 03' W	28.
N 40° 15' W	38.
N 7° 30' W	50.

With this d

Filed

Field

J. M.

Geo.

after

bill

like

View

on t

upp

end

Witness our respective hands at Pendleton, Oregon.
 this day of June A. D. 1892

Eugene Rieth
 Burr Johnson
 Hiram Flickinger } Viewers. Road
 Survey No. 397.

Filed July 6. 1892
 W.M. Pierce }
 Clerk

Field Notes Road No 397

Field notes of Road Survey No. 397. for Umatilla Co. Oregon

I met Eugene Rieth, Burr Johnson and Hiram Flickinger, Viewers on Road Survey No. 397 for Umatilla Co. Ogn. after qualifying them, according to law. we call J. C. Hill and J. M. Jarvis to chain and mark, who were each like wise duly qualified - under the direction of said Viewers I proceed to the survey of Road No. 397: =

I cut R 397-0- on E. face of post at E end of Railing on the north or lower side of what is known as the upper McKay bridge and from the center of the east end of said bridge about 20 chs. S.E. of center of Sec. 34 T27N. R32E

Course	Dist. chs.	Turn	Remarks
N 14° 37 W	0.75	L. 62° 37'	Set angle post mkd. 1
N 46° 34 W	55.70	L. 31° 51'	" " " 2
	80.00		" 1 M. p 45 links E. of line.
N 31° 09 W	14.12	R. 15° 25'	Set a. p. mkd 3
N 23° 24 W	20.00	R. 7° 45'	" " " 4
N 41° 54 W	28.35	L. 18° 30'	" " " 5, Descend steep grade to creek bottom.
N 44° 31 W	29.23	L. 2° 37'	" " " 6
N 34° 53 W	58.40	R. 9° 38'	" " " 7
N 24° 53 W	66.87	R. 10° 00'	" " " 8
	70.83		Center line
N 19° 08 W	75.23	R. 5° 45'	" " " 9
	80.00		a basalt boulder 32 x 24 x 24 ins. brass west 45 lbs distant. marked 11 M for 2. m. point.
N 75° 25 W	14.17	L. 6° 20'	Set a. p. mkd 10
N. 72° 55 W.	19.15	R. 2° 27'	" " " 11
N 7-70 E	23.70	R. 30° 15'	" " " 12
N 70° 03 W	28.81	L. 27° 23'	" " " 13
N 40° 15 W	38.83	L. 20° 12'	" " " 14 J. Chrissinger's house, about 4 chs. N.W.
N 7-30 W	50.83	R. 32° 45'	" " " 15

N 15-13 W	55.30	S. 7° 43'	" " "	16	
N 22-33 W	62.06	S. 7° 20'	" " "	17	= Leann's barn brass west 183 lks. dist.
N 7-53 W	64.47	R. 14° 40'	" " "	18	
N 10-53 W	66.97	S. 3° 00'	" " "	19	
	73.50		Int. E. + W. fence 508 lks. west of 1/4 Sec. Cor. bet. Secs. 16 + 21.		
	80.00		Set 3 m. p. 45 lks. west of line.		
N 3-37 E	8.81	R. 14° 30'	Set a. p. MKD. 20		
	13.50				Old road to lower McKay bridge
N 21-55 W	15.43	S. 25° 32'	" " "	21	
	20.50		Ravine, about 10 lks. deep, 75 lks. from bank to bank on line of road, - Descend gully		
N 15-55 W	43.40	R. 6° 00'	Set a. p. MKD. 22,		J. H. Raley's pump brass E. 47 lks.
N 46-33 E	52.70	R. 62° 28'	" " "	23	Ascend hill,
N 57-03 E	58.29	R. 10° 30'	" " "	24	
N 60-06 E	71.00	R. 3° 03'	" " "	25	
	80.00		" 4 m. p. 84 links N. of line, against fence on N. side of lane - ^{note} at this place, the Viewers changed the survey after setting the 4 m. p., which was set 34 links N. of road center, throwing the line of survey at this point 50 lks. south of the first survey, and I leave 4 m. p. unchanged		
S 60-20 E	16.17	R. 59° 34'	The 1/4 Sec. Cor. on N. body of N.E. 1/4 of Sec. 16.		
			Set a. p. MKD. 26.		on main summit - Descend hill
N 88-40 E	19.87	S. 31° 00'	" " "	27	
N 58-50 E	22.46	S. 29° 50'	" " "	28	
	28.20				Win fence, course E. + W.
	29.50				plowed furrow E + W. about 5 chs. W. of Sec. Cor.
N 38-05 E	34.47	S. 20° 45'	" " "	29	
N 10-55 W	39.38	S. 49° 00'	" " "	30	
	53.70		Center of S. end of bridge on Tudor Willow Creek. I cut R. 397 on lower brass at S. end of said bridge for terminus of said R. 397. - all posts over of the size and were marked and set in mounds, as required by law.		

Shenby certifies that the foregoing field notes to road survey 397 for Wasatilla County Oregon are correct.

Jno C. Arnold, Surveyor

Filed July 13 1892
 W.M. Pierce }
 Clerk

lks. dist.

secs. 16 + 21.

ridge


bank to bank

.47 lks.

st fence
cross
m. p., which
wing the
outh of
unchanged
ec. 16.
Descend hill

E. + W.
5 chs. W. of sec. cor.

Willow Creek
of said bridge
the size and
required by law.
and survey 397.

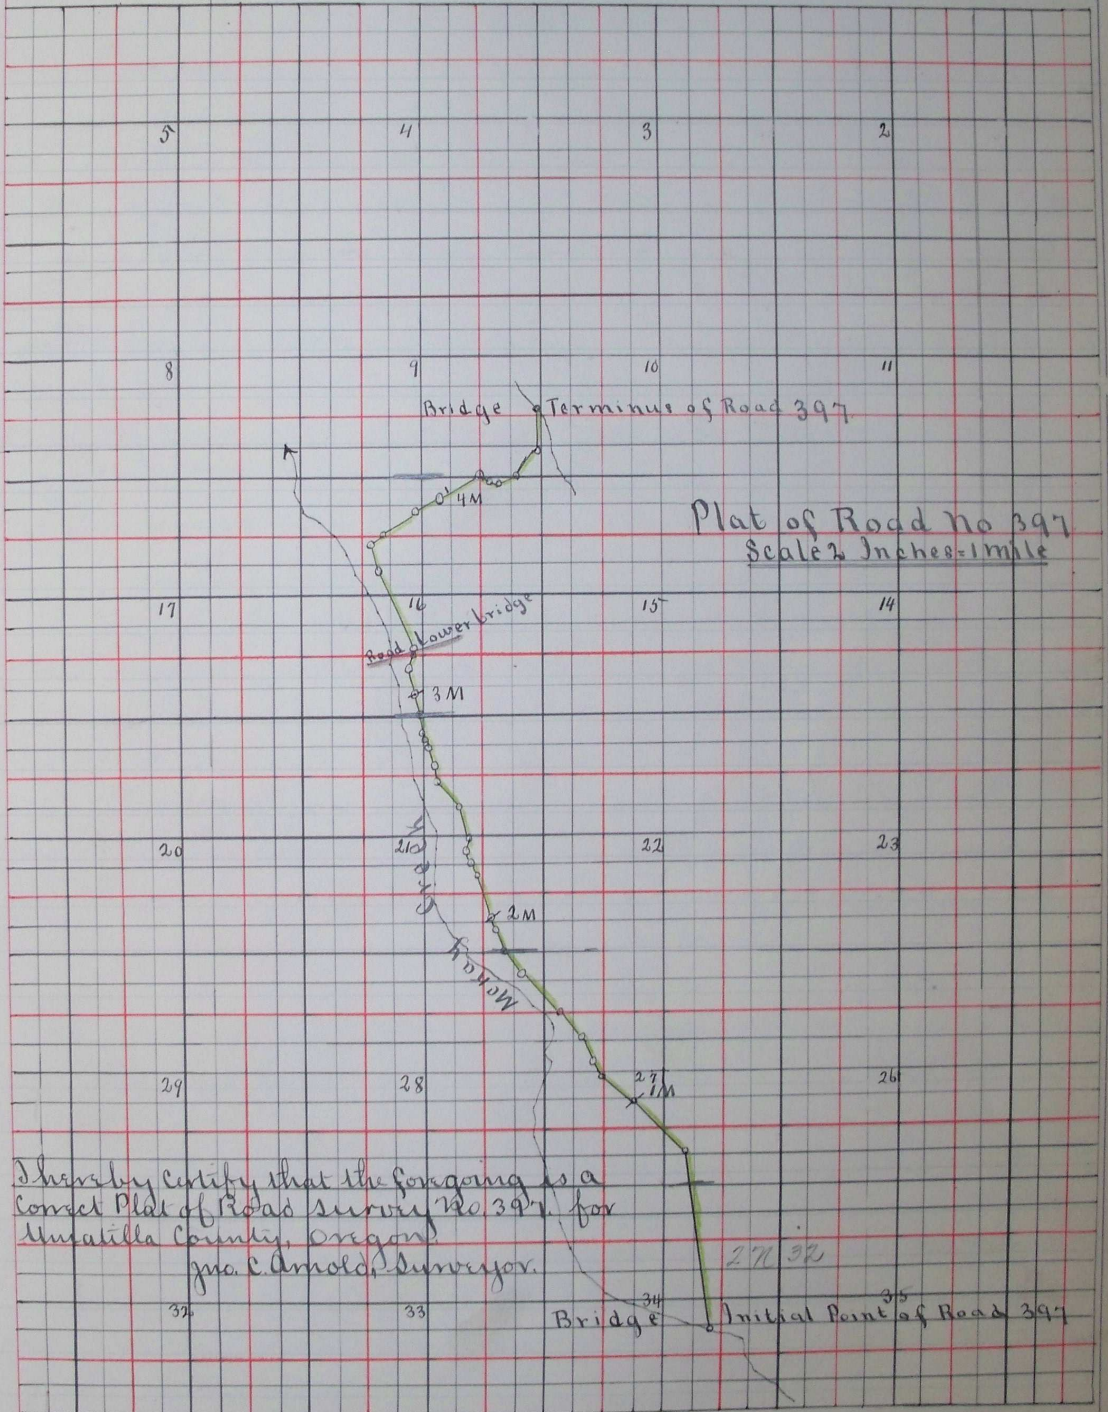

I hereby certify that the foregoing is a
Correct Plat of Road Survey No. 397 for
Umatilla County, Oregon
Jno. C. Arnold, Surveyor.

Filed July 13, 1892
W. M. Pierce
Clerk

1246