

Rd #82
 Report Field notes & Plat of County
 Road from Swifts Station to Matilla
 Landing on Columbia River via Prospect
 Farm

We the undersigned viewers appointed to view and report on proposed route for County Road running from Swifts Station to Matilla City met with J. B. Raley surveyor on the 26th day of Aug 1888 and proceeded to view the same we find the distance of proposed Road to be 33 miles & 15 chains and in our opinion is a great improvement over the old travelled Road. after considering the matter we hereby leave to Report favorable and recommend its adoption as a County Road at your next session

Very Respectfully
 A. W. Nye
 J. W. Ellis } Viewers

Field notes on Road from
 Swifts Station to Matilla

Set Post marked "R" in Road
 near fence opposite old Swift Station & run
 N 48° W 17^{ch 21} set a Post
 N 20° W 13 " " "
 N 59° W 34.80^{ch} " " "
 N 58° W 15.50 " 1 m Post raised mound
 " " " 47.00 " a Post
 N 41° " 32.50 " 2 mile post raised mound
 " " " 10. " a Post
 N 60° " 70 " 3 mile Post mound &
 " " " 45 " a Post
 S 44° " 35 " 4 mile post mound &
 N 11° " 45 " a Post
 N 85° " 29 " " "
 N 59° " 6 " 5 mile post mound &
 " " " 87 " a Post
 N 63° " 23 " 6 m Post
 " " " 15 " a Post
 N 59° " 75 " 7 m Post mound &
 " " " 20 " a Post

	ch	ex	
Rd #82 S 70° W	41	50	set a post
N 35° W	18	50	" 8 m Post mound &c
" " "	44		" a Post
N 50° W	36		" 9 m Post mound &c
" " "	80		" 10 m Post " "
" " "	5		" a Post
" 15° "	70		" 11 m Post mound &c
" 61° "	5		" 11 m Post " "
" " "	10		" a Post
N 30° "	10		" Eyes Well sheep Ranch
" " "	35		" angle Post
N 80° "	20		" " "
S 74° "	5		" 12 m Post raised mound
S 74° "	10		" angle post
N 78° "	37.50		" " "
N 60° "	32.50		" 13 m Post mound &c
" " "	40		" Angle Post
N 39° "	30		" " "
N 88° "	10		" 14 m Post mound &c
" " "	115		" angle Post
N 85° "	35		" 15 m Post mound &c
" " "	13		" angle "
S 60° "	40		" " "
N 73° "	27		" 16 m Post " "
" " "	58		" angle Post
S 80° "	48		" " " SE bar
S 76° "			of mowhouses house
" " "	22		" 17 m Post mound &c
" " "	48		" Angle Post
N 80° "	22.50		" " "
N 28° "	9.50		" 18 m Post mound &c
" " "	33.50		" Angle Post
" 45° "	46.50		set 19 m Post with mound &c
" " "	80		" 20 " " " "
" " "	1250		" angle Post
" 20° "	67.50		" 21 m Post mound &c
" " "	80.		" 22 " " " "
" " "	63.		" angle Post
" 43° "	17.		" 23 mile Post " "

Rd #82 N 45° W 80^{ch} set 24 m Post mound &c
 " " " 45 to intersect cold Spring cañon just below
 the spring and set 25 mile Post with mound &c
 S. 65° W 5^{ch} set angle Post
 N 20° " 10' " " "
 " 53° " 65 " 26 m Post mound &c
 " " " 25 " angle Post
 " 57° " 53 " 27 m Post mound &c
 N 58° " 80 " 28 " " " "
 " 62 " 53 " angle Post
 N 53° " 25 " 29 m Post " "
 N 81 " 65 " angle Post
 West 15 " 30 mile Post " "
 N 68 W 80 " 31 " " " "
 N 38 W 80 " 32 " " " "
 N " " 14 " angle Post
 " 75° " 42.50 " " "
 West 23.50 " 33 mile Post on hill near the Smatilla River
 N 69° W to South end of main Street of Smatilla Landing thence
 N 15° W " N W cor of 10 Horns Hotel + marked R on a large
 post for the terminus the Road the total length is 33.2 miles
 + 15 chains survey was begun Aug 26 1880 with A W nizer
 Wm Ellis viewers and R. A Fuller + G B. Wade chain men
 J H Raley, Surveyor

mmL


















Rd #82

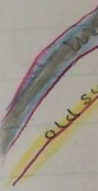

6182

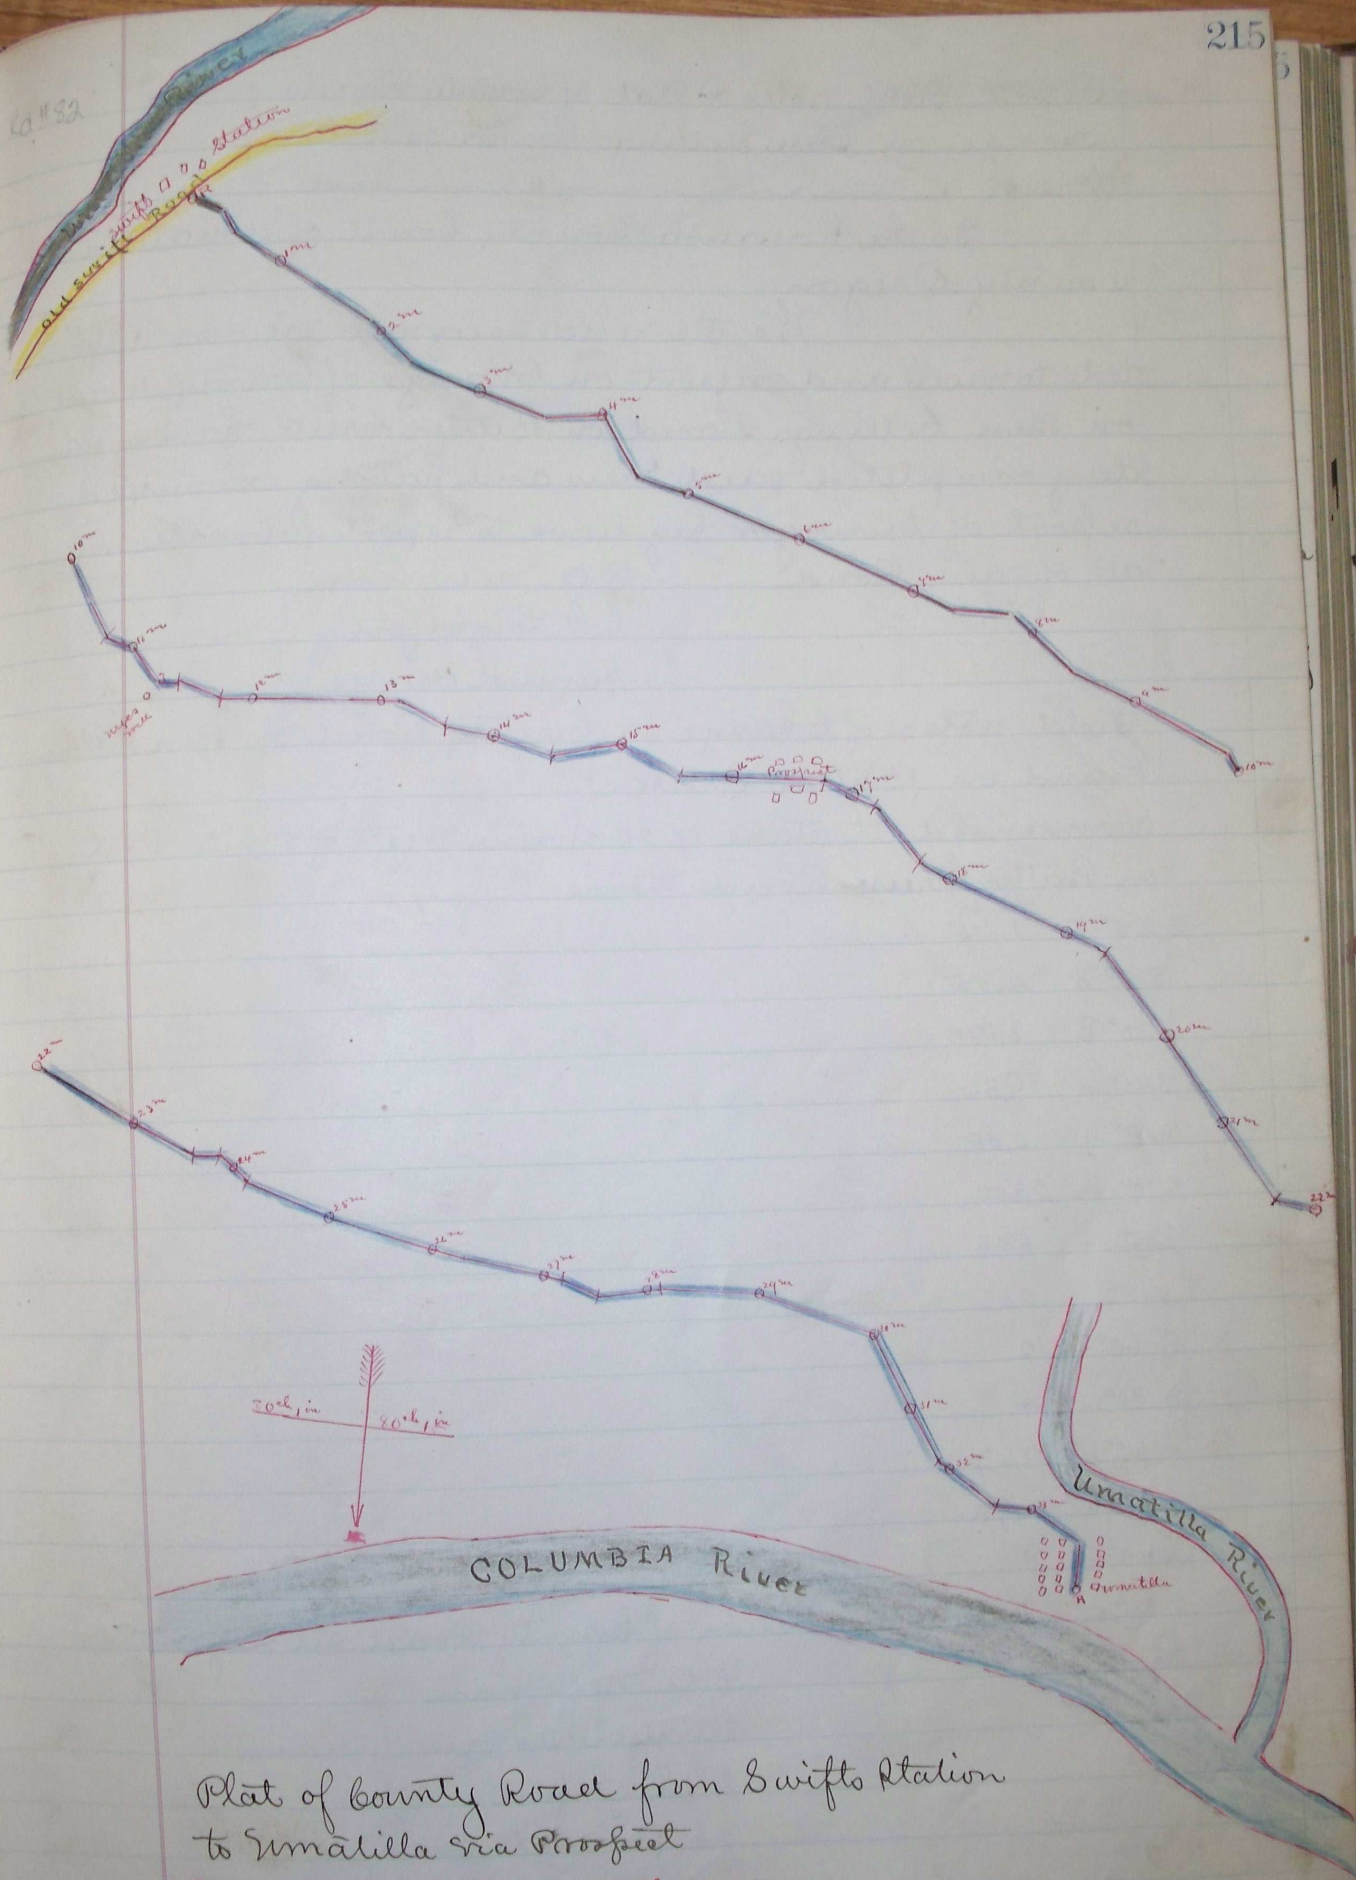

Plot of County Road from Swifts Station
 to Umattilla via Prospect
 Journal D. Page 607
 " E. " 43