

ROAD No

322.

Road No. 322.

Report of Viewers, field notes & Survey of change in Co. Road No. 171.

To the Hon. County Court of Umatilla County, Oregon.

We your viewers appointed to view out & locate the proposed change in County Road No. 171 respectfully report that we met at the time & place appointed and proceeded to view, survey & locate the proposed change in accordance with petition & with Field Notes & Survey accompanying this Report.

We find the same to be a practicable route being in as about as good condition & a better & shorter route than the old road & we therefore recommend that the same be declared a public highway.

J. M. Deizer } Viewers
J. S. McLeod }

- Field Notes -

- of -

- Change in Road No. 171 -

To the Hon. County Court
of Umatilla County Oregon.

I hereby certify that on the 7th day of March 1889 after qualifying J. M. Deizer & J. S. McLeod as viewers & George Smith & W^m Culp as chainmen I proceeded to survey off the proposed change in County Road No. 171 as described in the accompanying Field Notes & Plat.

- Field Notes -

Beginning at a point 20 rods West from the South East Corner of the S.W¹/₄ of Sec 36 in T. 4. N of R. 28 E. of W. M. in said County being 50 feet West of a small bridge over which said road now passes; set post marked R, thence

W. 32° N 220 Rods, Angle, thence

N 19° W 40 Rods, Angle, thence

West 60 Rods, set post marked M. 1; thence

West 244 Rods to intersection of old road set post marked R.

For Plat see Page 57


Filed April
1889
W. Hartman

change in
appointed and
with petition
is good condit-
and that the
were

89 after qual-
as chain-
to 171 as de-

ner of the
West of a
R, thence

J. N. R. 28 E.

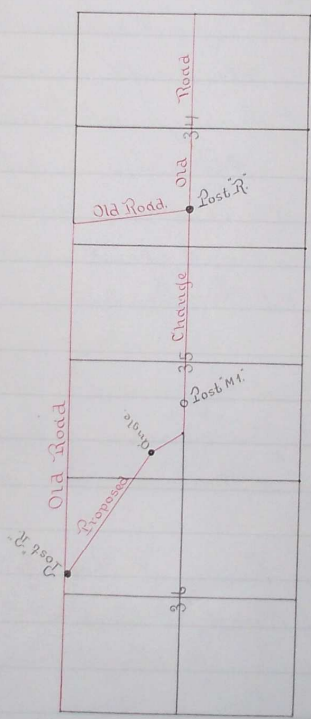

Change is at.

E. E. Sharon
Surveyor.

Filed April 1st 1889
G. A. Hartman, Clerk
G.A.