


Plat of Road No. 616  
in T. 4 N. R. 28 E. W. 4 E.

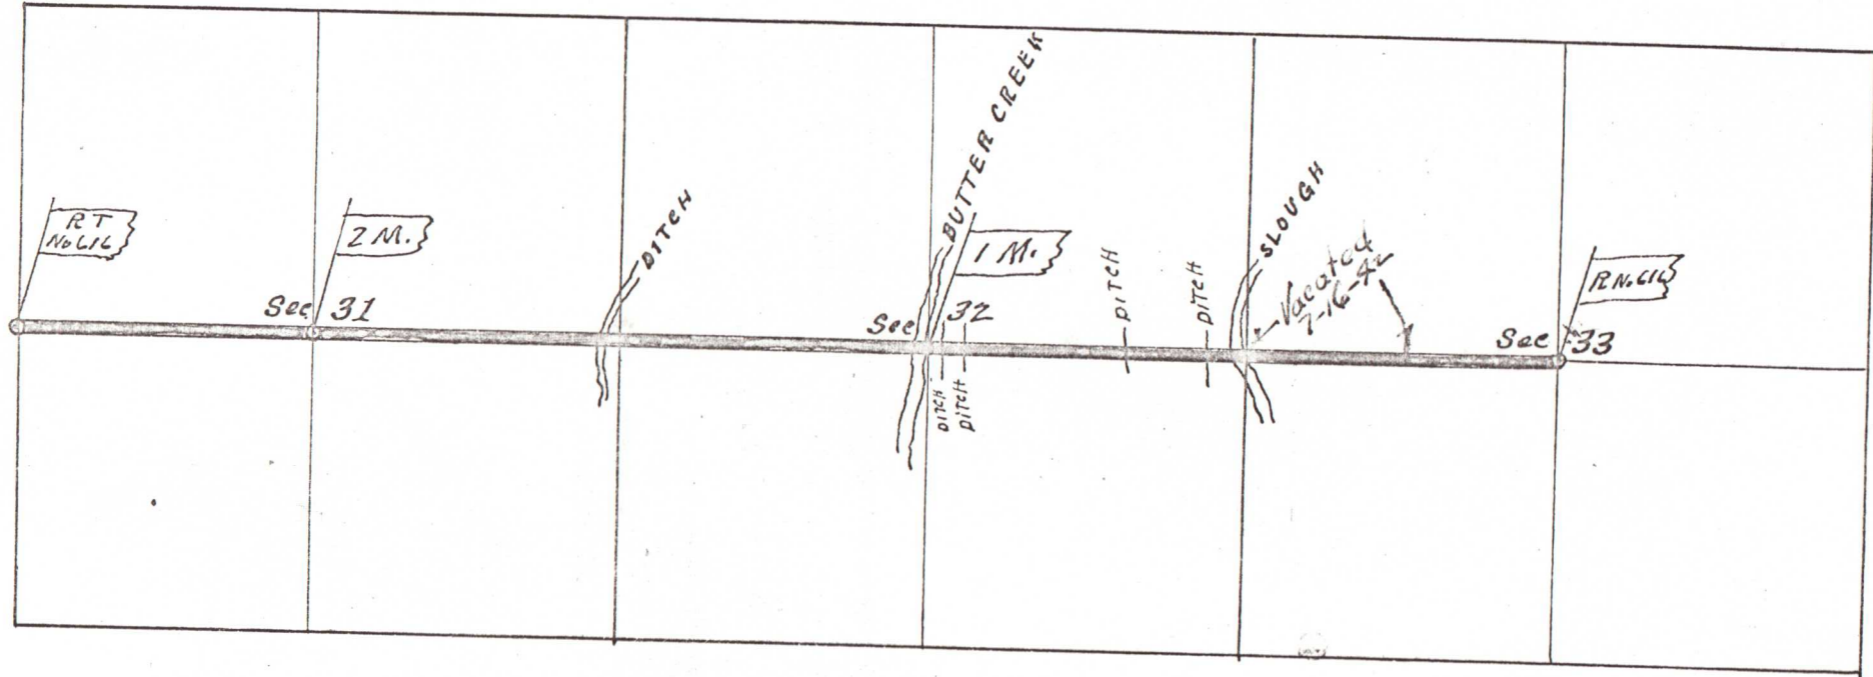

TRUE Meridian  
Var 21° E  
Scale 25 chs 1"

616