

ROAD No

172

## Road No 172

Report of Viewers. Field Notes and Plat of Survey of a County Road commencing at road leading from O. F. Thompsons to intersect road to Prospect. To the Hon the County Court of Umatilla County, Oregon.

We your viewers appointed to view, survey and locate a proposed County Road No 172 running from stake driven in County Road (running from O. F. Thompsons to Echo) and thence through town of Foster to Prospect road. We leave to report as follows to-wit: We find the route of which the said proposed road passes to be entirely practicable, with the exception of two sloughs on the meadows which could easily be bridged or filled in. also the crossing of the Umatilla River near the town of Foster, which would require a bridge to make the road practicable during high water. We consider this road to be a great benefit to the travelling public and parties living along the line of the same and would therefore recommend that the same may be declared a public highway.

Oct 5<sup>th</sup> 1883.

N. E. Crawford

J. L. Moorhouse

John Edwards.


Survey of County Road commencing at road leading from O. F. Thompsons to intersect road to Prospect.

Drove a stake  $\frac{1}{4}$  mile East of 5 mile stake on road running from Thompsons to Echo

Thence N.  $65^{\circ}$  E. 27.00 point angle. Thence N  $22^{\circ}$  E. 80.00 1 mile 30.00 point angle. Thence N.  $51^{\circ}$  E. 80.00 2 miles. 10.00 point angle. Thence N.  $46^{\circ}$  E. 80.00 3 miles angle Thence N.  $52^{\circ}$  E. 80.00 4 miles angle Thence N  $75^{\circ}$  E. 25 point. Thence East S. W. corner Seals field. 67.50 point Thence North down Seal Lane 80.00. 5 miles. 80.00. 6 miles. 30.00 cross slough 2 chs wide. 48.00 cross slough 2 chs wide. 69.00 point Thence S.  $78^{\circ}$  E. 80.00. 7 miles. 9.00 point Thence East 22.50 point Thence N.  $32^{\circ}$  E. 35.00 Left bank Umatilla River Thence N.  $50^{\circ}$  E. 37.50 right bank Umatilla River and foot of Seymour Street in Foster. 60.00 East boundary of Foster Thence N.  $40^{\circ}$  W. 76.00 point Thence N.  $85^{\circ}$  E. 80.00. 8 miles. 45.00 point Thence N.  $70^{\circ}$  E. 80.00. 9 miles. 70.00 point Thence N.  $55^{\circ}$  E. 80.00. 10 miles. 80.00. 11 miles. 2.50. point Thence East. 80.00. 12 miles. 33.50 Terminus. Intersect Road from Prospect to Umatilla.

Road No 172.

Map of County Road surveyed from A situated on County Road running from Ranch of O. F. Thompsons on Butter Creek to each between 5<sup>th</sup> & 6<sup>th</sup> mile posts. thence by Bat Foster to C. the point of termination on County road running from Umatilla via Prospect to Pendleton.

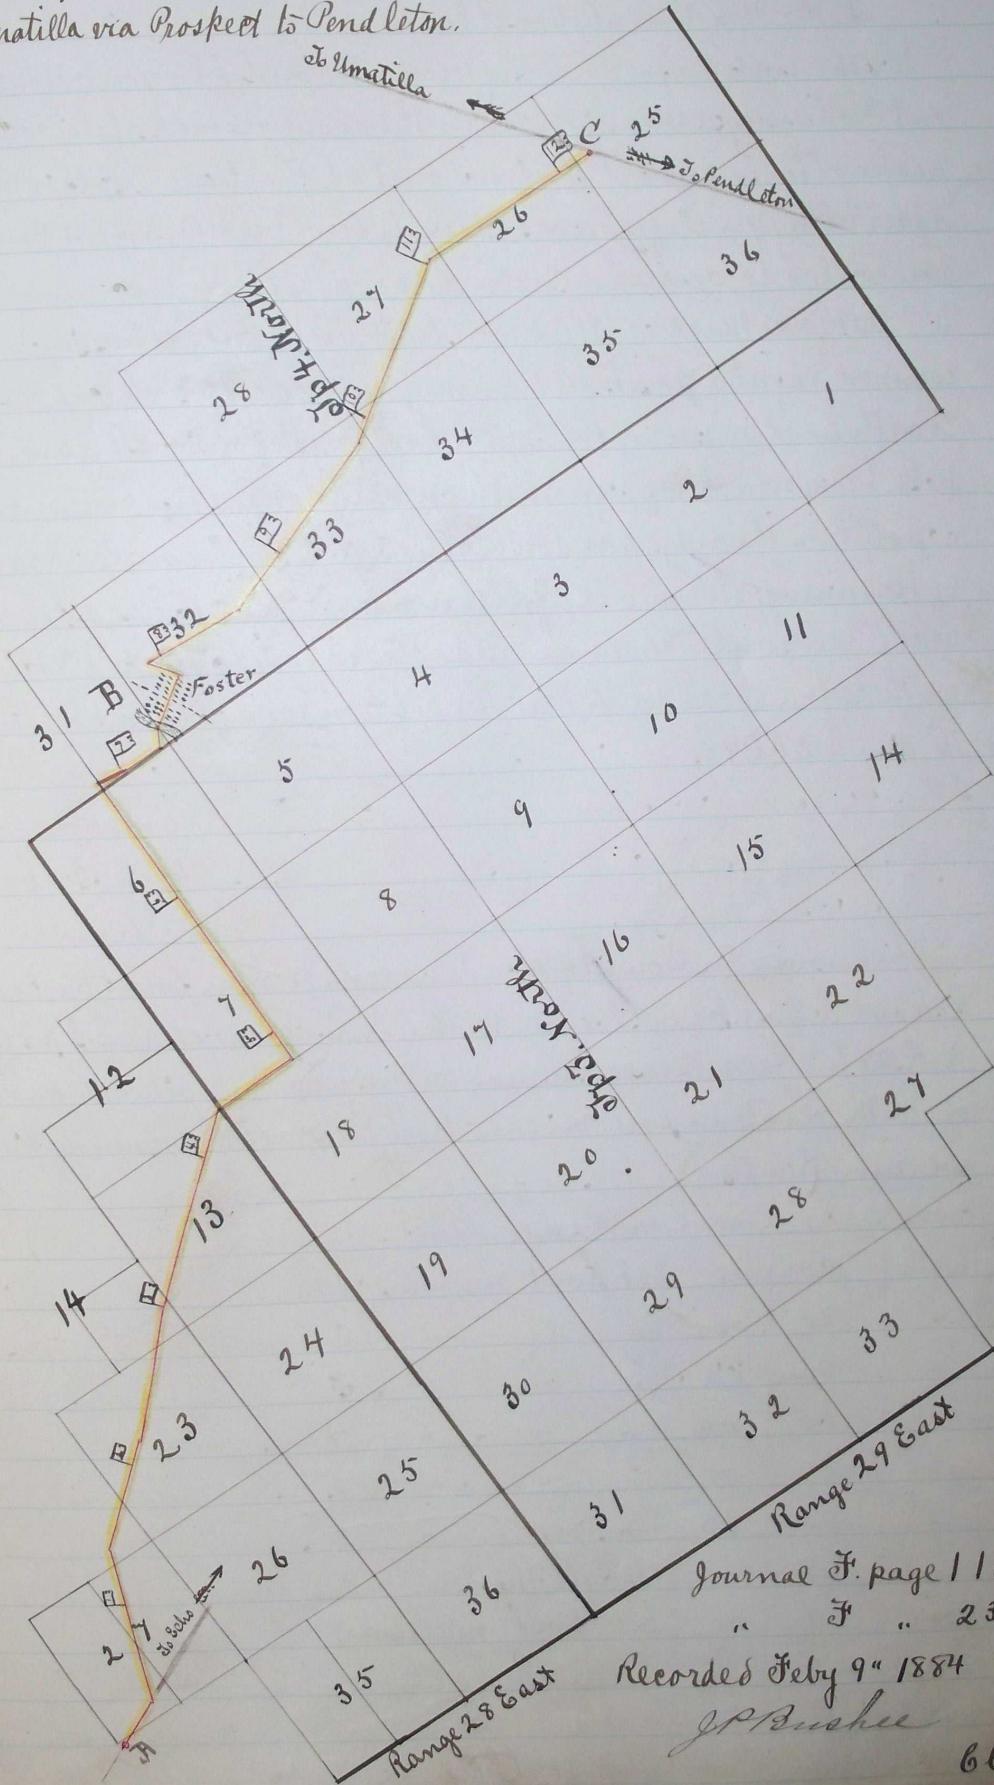

Journal F. page 116

" F " 237

Recorded Feby 9<sup>th</sup> 1884

J.P. Bushie

Clerk