

in Township 3 North Range 28 East W. Mt.  
and Township 2 North Ranges 27-28 and 29 East W. Mt.


True N  
Scale 25 ch: 1"

T. 3. N. R. 28. E.

T. 3. N. R. 29. E.

T. 2. N. R. 28. E.

T. 2. N. R. 29. E.

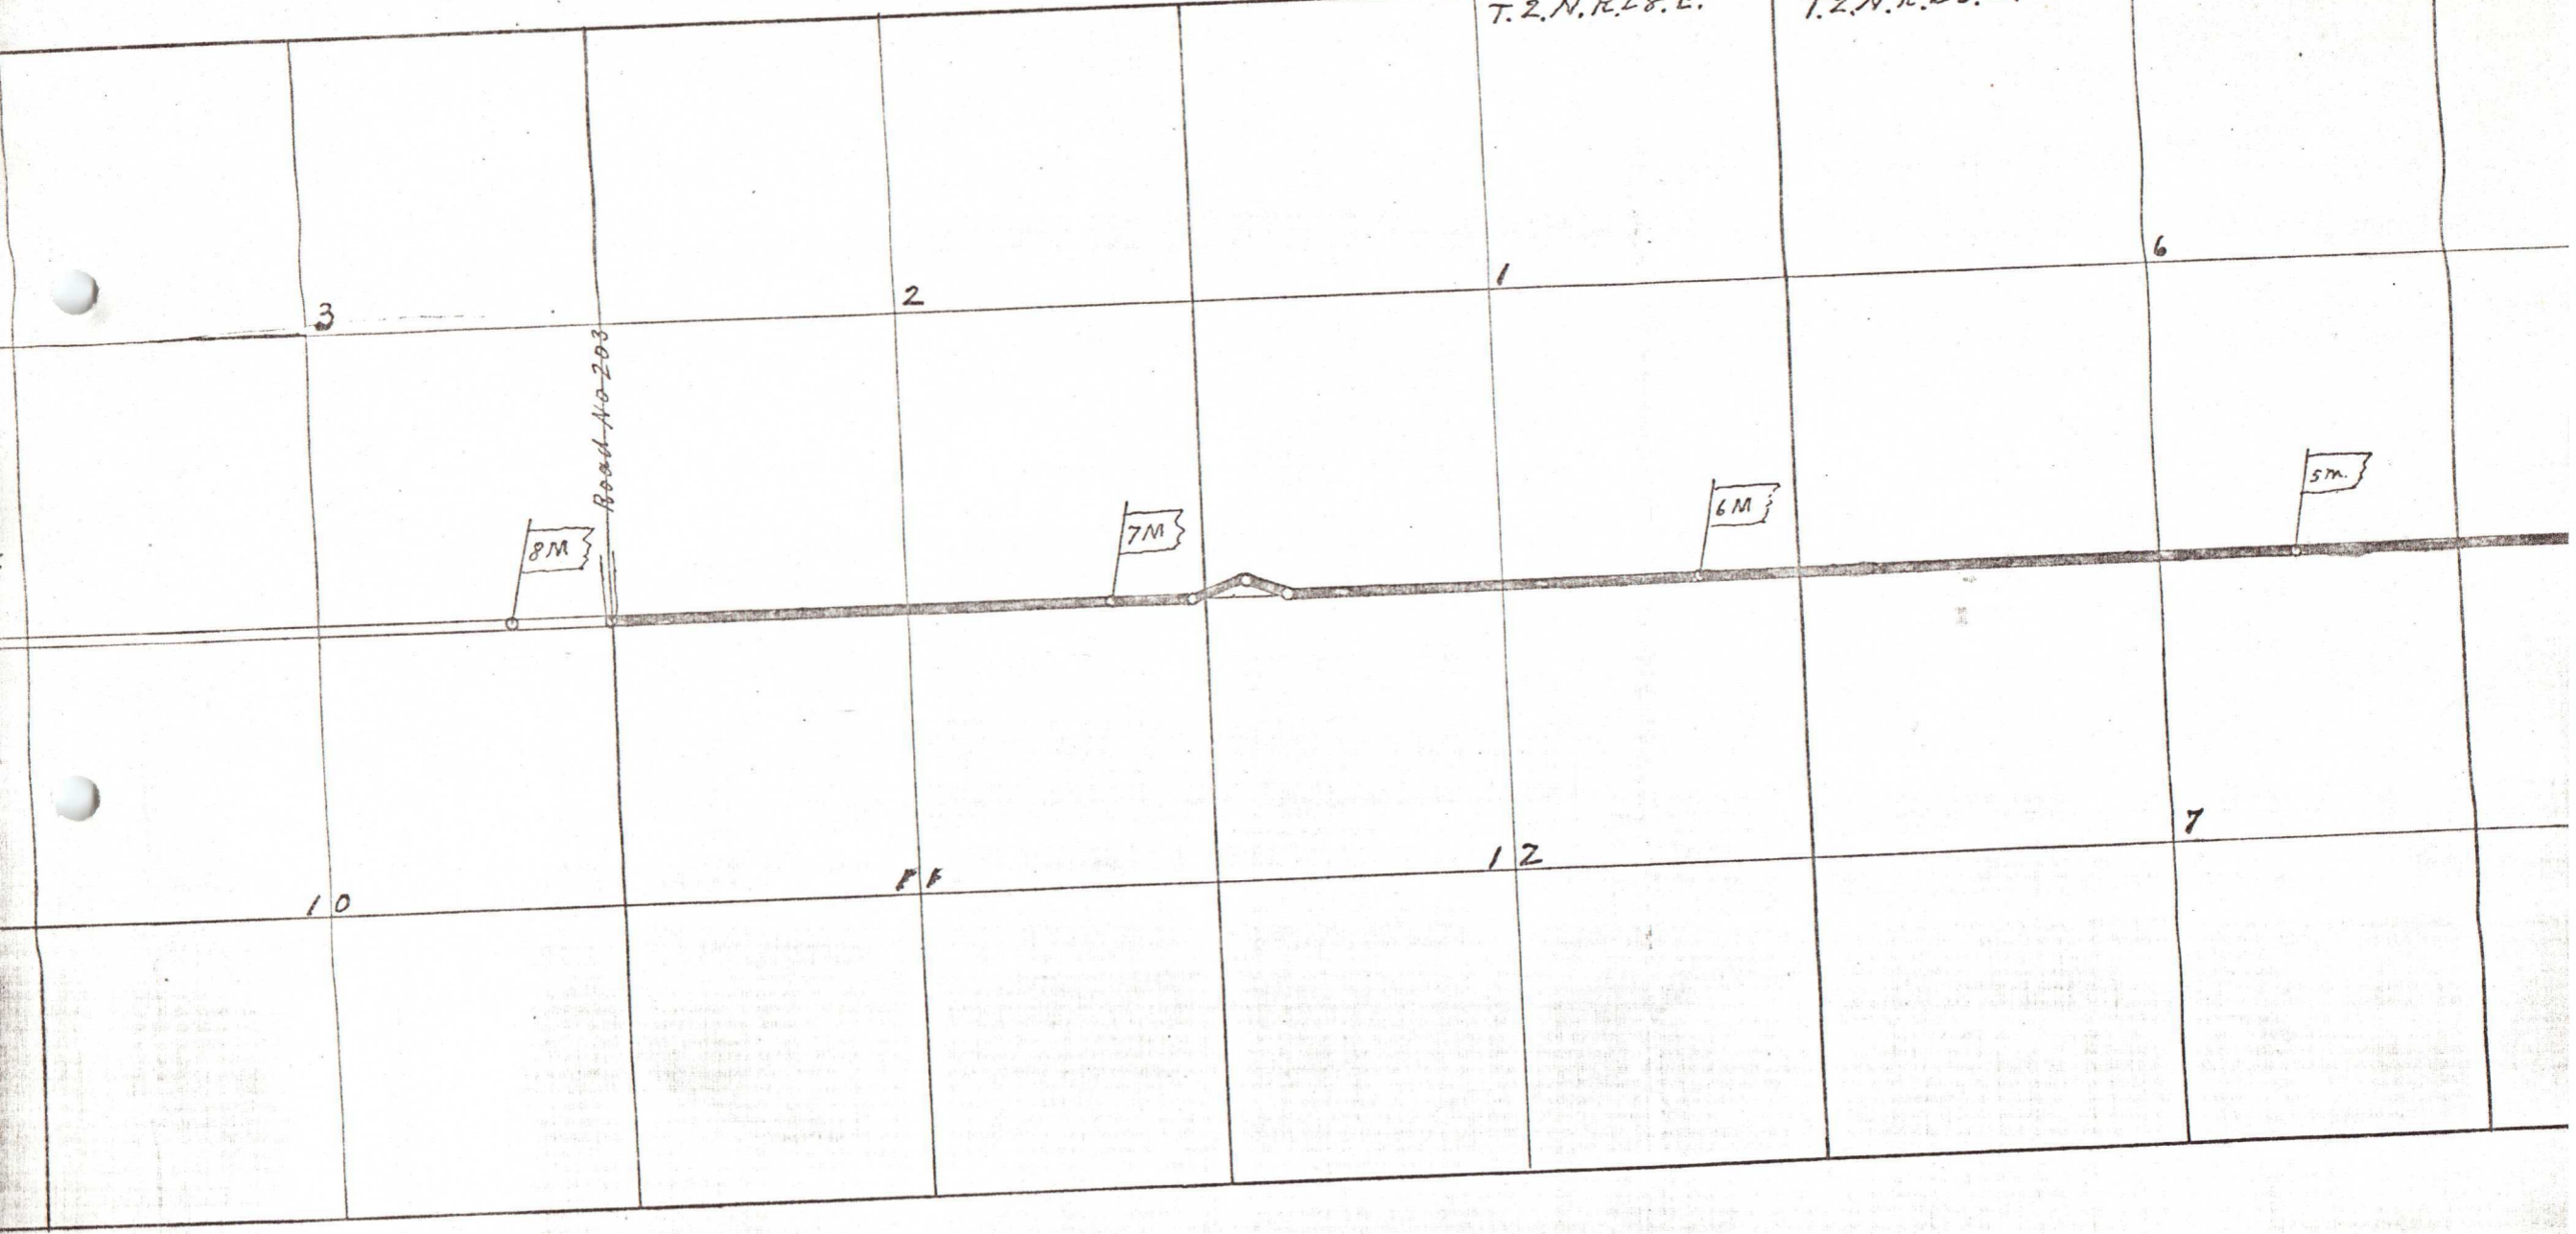

T. 2. N. R. 27. E.

1

6

5

4

RT  
V. 665

12M

11M

10M

9M

road No. 203

road No. 203

12

7

8

9

ch: 1"

T.3.N.R.28.E.  
T.2.N.R.28.E.

Found  
Fence  
Marked  
T.3.N.R.29.E.  
T.2.N.R.29.E.

6M

set 1/2" I.P.  
set stone

5M

Found Old Post

4M

14"  
1/2" I.P.  
set stone

3M

5/8" I.P.  
stone

31

1 1/8" I.P.  
stone

3

2 1/2" I.P.  
set stone

set 1 1/2" I.P.  
set stone

1/2" I.P.  
set stone

30

1 1/2" I.P.  
stone

2M.

1 1/2" I.P.  
set stone

Fence Corner  
set 1 1/2" I.P.  
set stone

Found Stone  
set 1 1/2" I.P.

29

1M.

20

19

