


T 1 South R. 32 E

Scale 4 inches to the mile

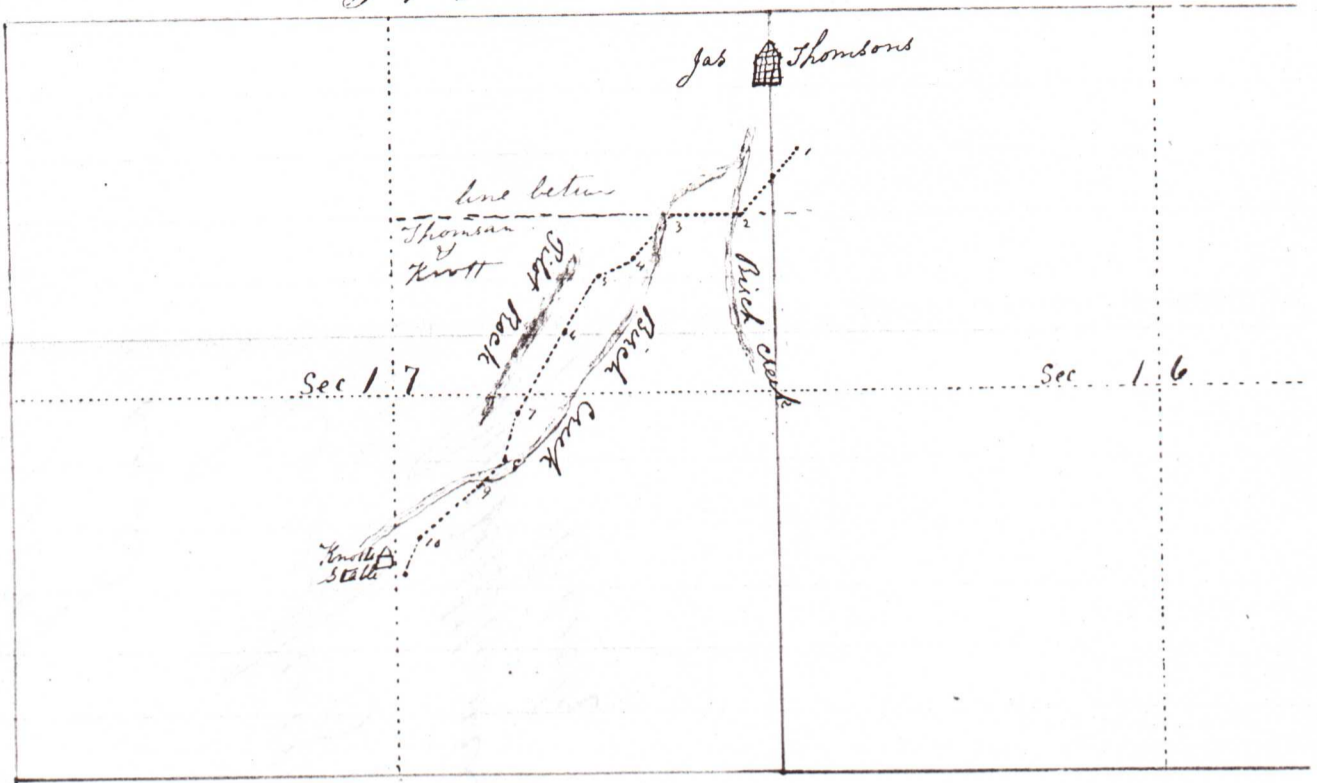

Station	Bearings	Dist	
1	S 40° W	9 <sup>34</sup> / <sub>100</sub>	To Crossing of Creek
2	West	7	1st Chain Crosses Creek
3	S 42 <sup>1</sup> / <sub>2</sub> ° W	6	crosses right branch Creek
4	S 62° W	4	foot of bluff or
5	S 32 <sup>1</sup> / <sub>2</sub> ° W	7	Pilot rock
6	S 31 <sup>1</sup> / <sub>2</sub> ° W	10	crosses creek
7	S 17 <sup>1</sup> / <sub>2</sub> ° W	5-	Through Sturdevants field
8	S 42 <sup>1</sup> / <sub>2</sub> ° W	4	
9	S 52 <sup>1</sup> / <sub>2</sub> ° W	8	
10	S 19 <sup>1</sup> / <sub>2</sub> ° W	4	To intersect Co road near Knotts Stall

I certify that the above is a correct copy of the field notes of a change in County road as ordered by Co Court at April Term accompanying is plat of same Surveyed June 4<sup>th</sup> 1872

Chairman { W. W. Carpenter } J. H. Sharon  
 { Geo. W. Mc Cleary } Surveyor