

Report, Survey and Plat of County Road from Stumphills

Rd #10

3

Millers ranch on Blue Mts.

Pendleton July 5th 1870


We the viewers appointed by said court at the April term to view out and survey the road from Stumphills to millers ranch Blue mountains proceeded with County Surveyor to view out and survey the same according to law and would recommend its location as a public benefit

S. L. Morse
E. Welch

Pendleton July 1st 1870

I do hereby certify that the within is a true copy of the field notes as taken by me of the road from Stumphills to millers ranch in the Blue mountains surveyed by order of County Court and under the direction of the viewers E. Welch and Morse appointed and ordered at the April term of said court accompanying this is a plat of the same

Chairman } W Goodwin
 } Phipps
 } Smith
J. W. Shiron
Surveyor.

Courses	Courses	Dist chains	Remarks.
	Commencing at	stake near	Stumphills thence
S 88 1/2 N	30		
S 26 N	50		1 mile opposite Phipps Ranch
S 30 N	80		2 miles " Thompsons "
S 30 N	8		
S 82 N	7		
S 44 N	5		
S 49 N	8		
S 75 N	8		Cross left fork Birch creek
S 21 1/2 N	6		30 School house
S 22 N	5		
S 22 N	24		Robbins corner
S 57 N	4		3 rd mile Robbins ranch
S 80 N	10		
S 80 N	10		20 Stutevants
S 45 N	20		
S 42 N	10		
S 46 N	30		
S 28 N	10		4 th mile stake opposite Cois ranch
S 38 N	10		
S 37 N	10		near Vaughns Ranch
S 42 1/2 N	10		
S 37 N	10		
S 82 1/2 N	10		5 th to Whites Ranch
S 47 N	10		
S 47 N	10		
S 30 1/2 N	10		
S 83 1/2 N	50		6 miles (continued p. 13)

Field Notes (continued)

Rd #10

Course or chain

Course or chain	dist	
S 88 1/2 W	20	
S 22 W	15	
S 14 W	28	
S 4 E	12	7 miles to Jones ranch
S 45 W	20	
S 11 W	10	
S 44 W	10	cross Birch creek
S 15 W	40	8 miles
S 15 W	40	School house
S 7 1/2 W	27	Beardsleys ranch
S 12 1/2 W	13	9 miles from Birch c.
S 12 1/2 W	7	
S 13 E	33	
S 6 W	40	10 miles
S 18 1/2 W	47	
S 11 W	8	
S 8 W	30	11 miles
S	40	
S 4 1/2 W	30	cross bridge on Birch creek
S 18 E	10	12 miles
S 13 E	20	13 miles
S 18 E	10	ascends the mountain
S 23 E	20	
S 35 E	20	
S 11 E	20	
S 9 W	10	14 miles
S 1 W	10	
S 6 W	22	
S 35 E	8	
S 6 1/2 E	24	
S 71 E	16	15 miles
S 71 E	23	to Millers Ranch.

Plat of Road from Newphills


Rd #10

30

Millers ranch, Blue mts

Town 8 R. 22 E

Base line

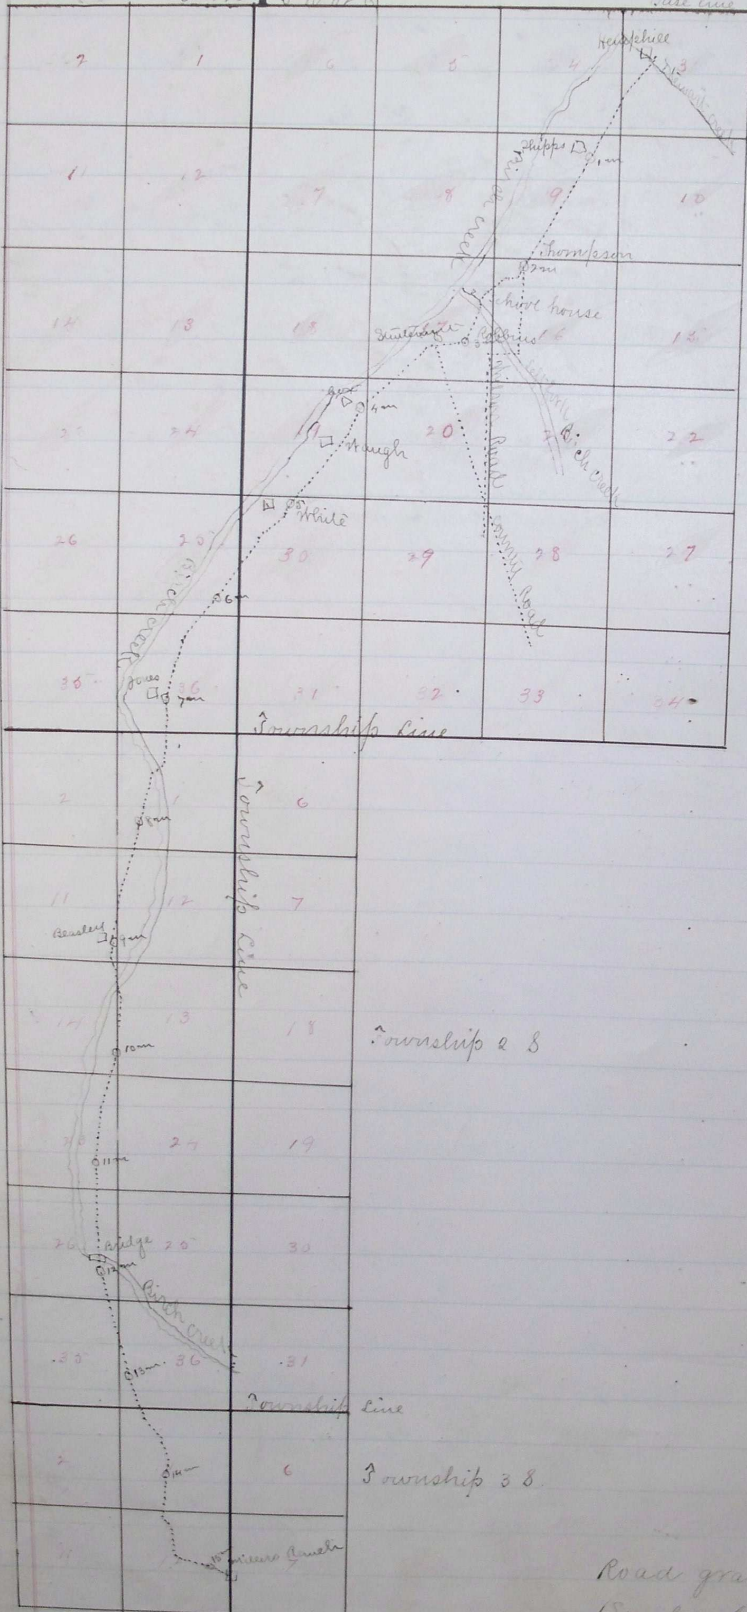

Township 1 S

Township 2 S

Township 3 S

Page 316

Road granted Sept. 5th 1870
(See Co. Court Journal page 10)